

OFFICE OF THE
DOUGLAS COUNTY SURVEYOR

Station: U-91

T 21 S, R 11W, Sec 32

Set By (Agency): DCSO

Date Set: 1973

Recovered By GQ-TP



Date Recovered 2-82

Recovered By _____

Date Recovered _____

Recovered By _____

Date Recovered _____

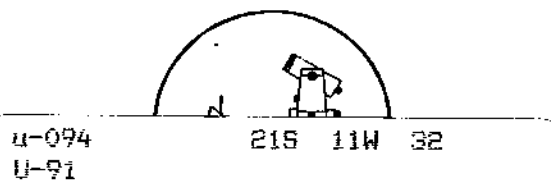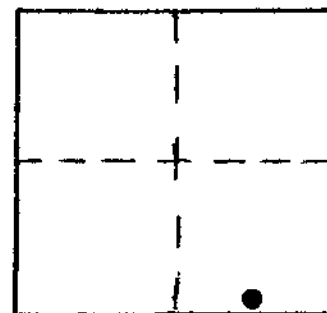

NAD 759361.94 3986377.18
83 43°41'46" 124° 2'10"

VERTICAL CONTROL

Elevation: 8.842 NGS Line # _____ USGS Line # _____ OSHD Line # _____

Precision: 2nd Agency: DCSO Proj. # 2006 Date: 1973

HORIZONTAL CONTROL

South Zone State Plane Coordinates: Y(Northing) 759,396.76 X(Easting) 1,065,416.33

Precision: 1/20,000 Agency: DCSO Proj. # 2006 Date: 1973


Approximate Geographic Position: Latitude 43°41'46" Longitude 124°02'05"

DESCRIPTION and TO REACH

SKETCH

Found: A standard DCSO disk set in a 12" x 18" x 20" rock 6' lower than the pavement, stamped "U-91 1973".

To reach: From the intersection of Hwy 38 & Co. Rd. #55 (in sec. 1 T22S R12W) proceed Easterly 1.65 miles along Hwy. 38 to monument on the right.

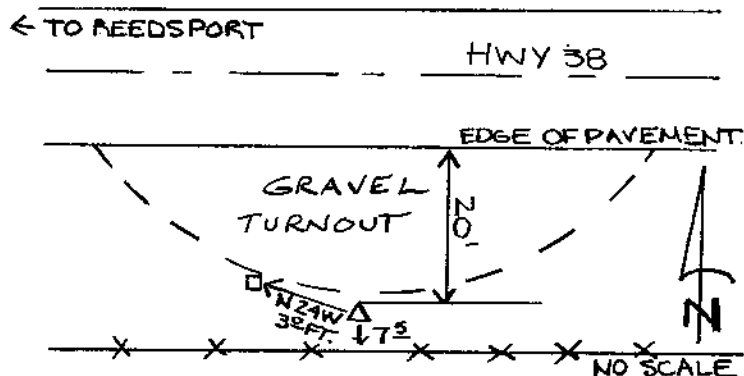

Reference Marks:

Note: For further information, contact the Douglas County Surveyor's Office, Room 205 Douglas County Justice Building, Roseburg, OR 97470. Phone 440-4278. Douglas County residents outside the Roseburg calling area, dial toll free 1-800-452-0991.