



OFFICE OF THE
DOUGLAS COUNTY SURVEYOR

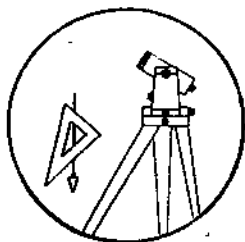

Station: J 612 T 21 S, R 12W , Sec 26
Set By (Agency): DCSO
Date Set: 1967
Recovered By GQ -- RWS
Date Recovered 1-20-82
Recovered By _____
Date Recovered _____
Recovered By _____
Date Recovered _____

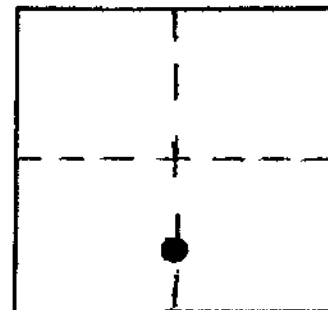

J 612
010
VERTICAL CONTROL

Elevation: 17.52 NGS Line # _____ USGS Line # _____ OSHD Line # 93C
Precision: 3rd Agency: DCSO Proj. # 2006 Date: 1989
(River Floodplain)

HORIZONTAL CONTROL

South Zone State Plane Coordinates: Y(Northing) _____ X(Easting) _____

Precision: _____ Agency: _____ Proj. # _____ Date: _____


Approximate Geographic Position: Latitude _____ Longitude _____

DESCRIPTION and TO REACH

SKETCH

Found: A standard Hwy. Dept. disk set in concrete bridge curb. Disk is 2.5 ft. in from S.E. corner of bridge over slough. Disk is stamped "J 612 1967".

To reach: From the intersection of Hwy. 101 & Co Rd. #48 (in sec. 26 T21S R12W) proceed easterly 0.25 miles along Rd. #48 to monument on the right.

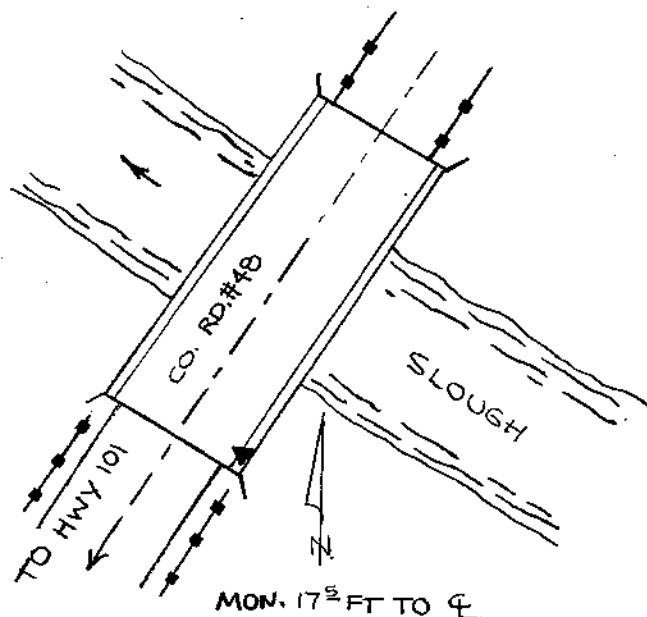

Reference Marks:

Note: For further information, contact the Douglas County Surveyor's Office, Room 205 Douglas County Justice Building, Roseburg, OR 97470. Phone 440-4278. Douglas County residents outside the Roseburg calling area, dial toll free 1-800-452-0991.