



OFFICE OF THE
DOUGLAS COUNTY SURVEYOR

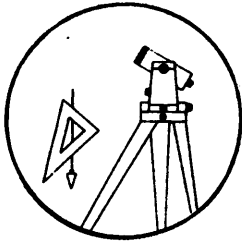

Station: K 612 T 21 S, R 12W , Sec 26
Set By (Agency): OSHD
Date Set: 1967
Recovered By TP-GQ
Date Recovered 1-20-82
Recovered By BOOK 7/03 RWS, STF
Date Recovered _____
Recovered By _____
Date Recovered _____

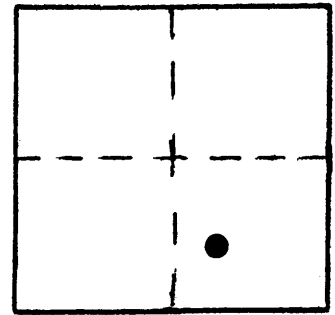

K 015

VERTICAL CONTROL NGVD 29

Elevation: 14.73 NGS Line # _____ USGS Line # _____ OSHD Line # 93C
Precision: 3rd Agency: DCSO Proj. # 2006 Date: 1989

HORIZONTAL CONTROL

South Zone State Plane Coordinates: Y(Northing) _____ X(Easting) _____


Precision: _____ Agency: _____ Proj. # _____ Date: _____

Approximate Geographic Position: Latitude 43° 42' 56" Longitude 124° 05' 33"

DESCRIPTION and TO REACH

Found: A standard State Hwy. Dept. disk set in bridge curb 2.5 ft. from N.W. Corner of bridge over slough.

To reach: From the intersection of Hwy. 101 and Co. Rd. #48 (in sec. 26 T21S R12 W) proceed easterly 0.3 mi. along Co. Rd. #48 to monument on the left.

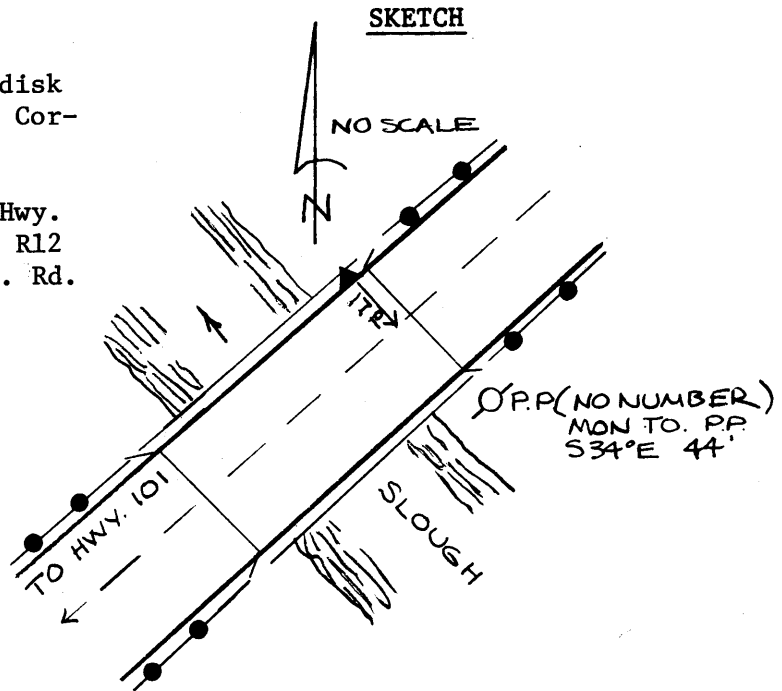

Reference Marks:

Note: For further information, contact the Douglas County Surveyor's Office, Room 205 Douglas County Justice Building, Roseburg, OR 97470. Phone 440-4278. Douglas County residents outside the Roseburg calling area, dial toll free 1-800-452-0991.