



OFFICE OF THE
DOUGLAS COUNTY SURVEYOR

Station: SC-1
Set By (Agency): DCSO
Date Set: 1973
Recovered By GQ-TP
Date Recovered 2-4-82
Recovered By _____
Date Recovered _____
Recovered By _____
Date Recovered _____

T 21 S, R 12W, Sec 34

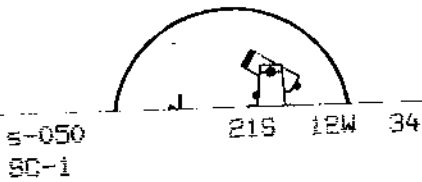

NAD 763331.69 3967285.85
83 43°42'17" 124° 6'32"

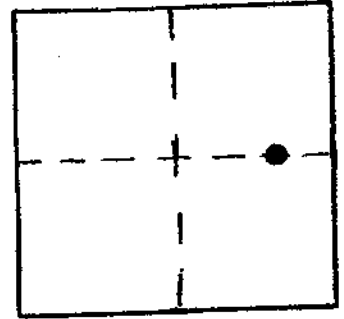

VERTICAL CONTROL

Elevation: 15.204 NGS Line # _____ USGS Line # _____ OSHD Line # _____
Precision: 2nd Agency: DCSO Proj. # 2006 Date: 1973

HORIZONTAL CONTROL


South Zone State Plane Coordinates: Y(Northing) 763,366.79 X(Easting) 1,046,325.24
Precision: 1/25,000 Agency: DCSO Proj. # 2006 Date: 1973
Approximate Geographic Position: Latitude 43°42'18" Longitude 124°06'27"

DESCRIPTION and TO REACH


SKETCH

Found: A standard DCSO disk set in concrete tile flush with ground, stamped "SC-1 1973".

To reach: From the intersection of Hwy 101 & Hwy 38 (in sec 34 T21S R12W). Proceed Westerly from intersection onto gravel Rd. on top of dike 0.2 mi. to 90° left turn and monument.

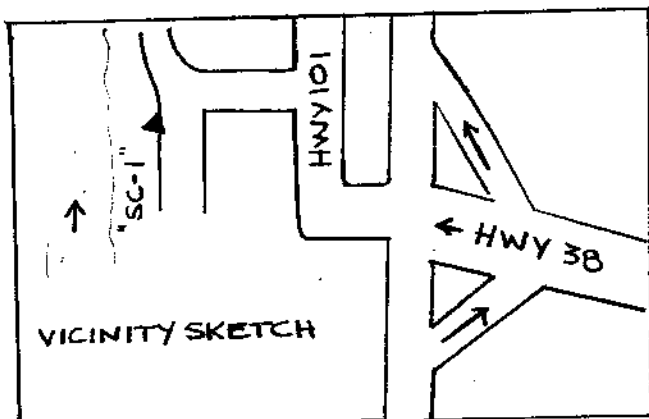

Reference Marks:

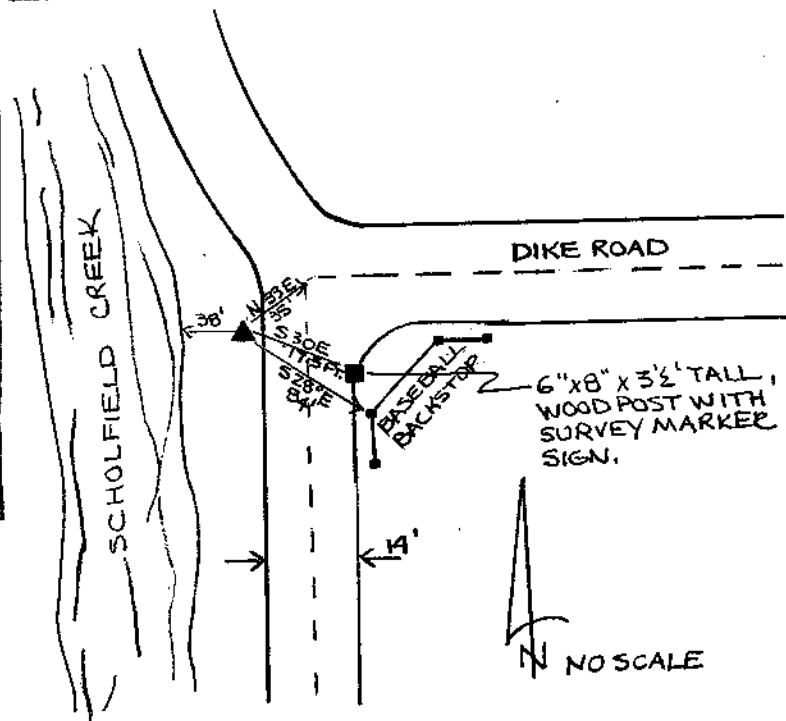

Note: For further information, contact the Douglas County Surveyor's Office, Room 205 Douglas County Justice Building, Roseburg, OR 97470. Phone 440-4278. Douglas County residents outside the Roseburg calling area, dial toll free 1-800-452-0991.