


OFFICE OF THE
DOUGLAS COUNTY SURVEYOR

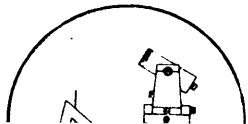


U 107
U 554

22S 5W 21

NAD 733792.54 4180575.64
83 43°38'46" 123°17'56"

Station: U 554 T 22 S, R 5 W, Sec 21
Set By (Agency): USC&GS
Date Set: 1954
Recovered By RWS, SJF
Date Recovered 1987, FD OK 5/03
Recovered By _____
Date Recovered _____
Recovered By _____
Date Recovered _____

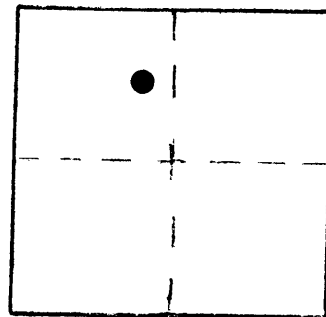

VERTICAL CONTROL NGVD 29

Elevation: 317.759 ft. NGS Line # 6 USGS Line # _____ OSHD Line # _____
Precision: 1st order Agency: USC&GS Proj. # _____ Date: 1957

HORIZONTAL CONTROL NAD 27

South Zone State Plane Coordinates: Y(Northing) 733,827.40 X(Easting) 1,259,615.09
Precision: 1/15,000 Agency: DCSO Proj. # 2008 Date: 1979
Approximate Geographic Position: Latitude 43°38'47" Longitude 123°17'52"


DESCRIPTION and TO REACH

SKETCH

A USC&GS disk stamped
"U 554 1954" set in top of con-
crete headwall of 24 inch diameter
culvert.

TO REACH:

From the intersection of
Boswell Road (Co. Rd. #54) and
State Highway 99 in T22S,R5W,
Sec. 21 proceed northerly along
State Highway 99 approximately
0.35 miles to monument on right.
Monument is set beyond rail-
road tracks and lower than
roadway.

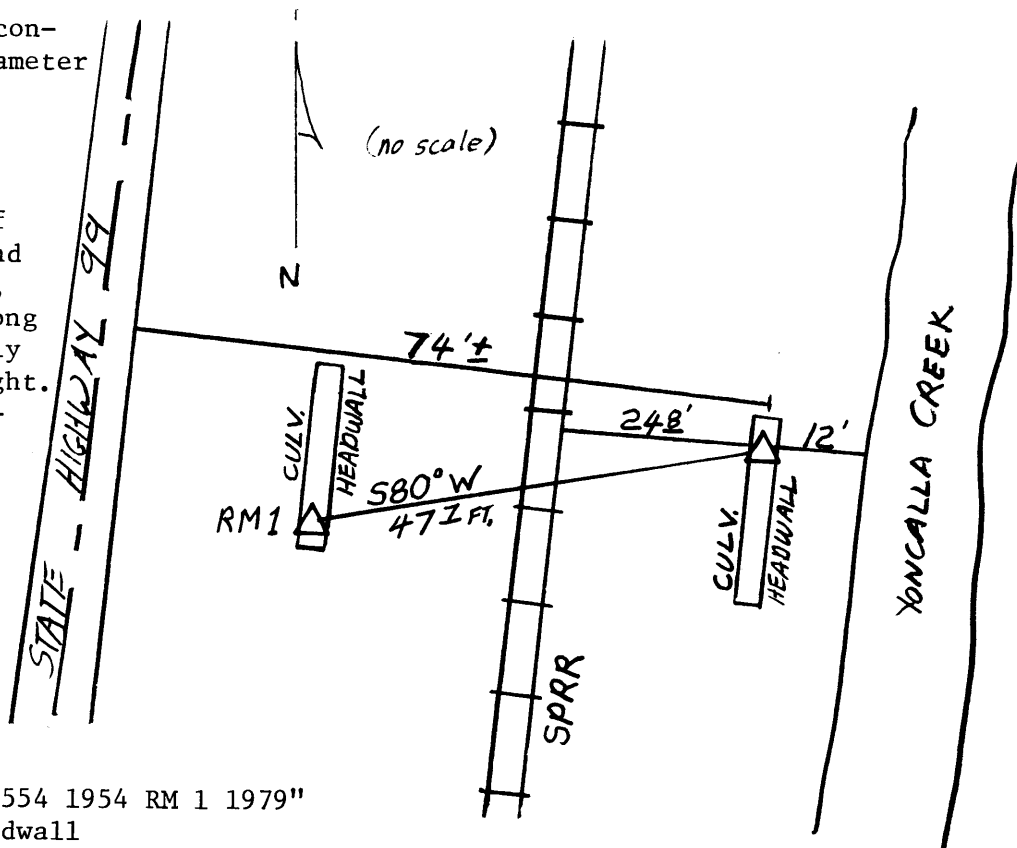

Reference Marks:

A DCSO disk stamped "U 554 1954 RM 1 1979"
set in a concrete culvert headwall
bears S82°24'36"W, 47.70 feet dist. (grid.).

Note: For further information, contact the Douglas County Surveyor's Office, Room 205
Douglas County Justice Building, Roseburg, OR 97470. Phone 440-4278. Douglas
County residents outside the Roseburg calling area, dial toll free 1-800-452-0991.