


Station: 133 B B
Date Set: 1919
Set By (Agency): USGS
Date Recovered: 12/28/98
Recovered By: SJF

T 22 S, R 8W, Sec 14

- Found New
 Reset Not Found
 Referenced Destroyed

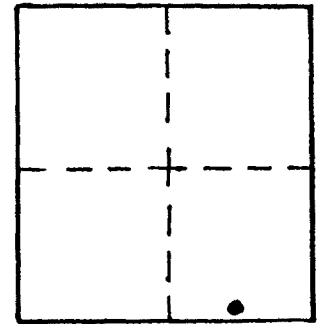

VERTICAL CONTROL NGVD 29

Elevation: 133,622 FT. NGS Line # _____ USGS Line # 16 OSHD Line # _____

Precision: 1ST Agency: USC&GS Proj. # _____ Date: 1958

HORIZONTAL CONTROL CORPSCON6 NAVD88 137.199 FT

South Zone O.C.S. 27: Y(Northing) _____ X(Easting) _____

South Zone O.C.S. 83: Y(Northing) 738333 X(Easting) 4098304

Precision: GIS SCALED Agency: DCSO Proj. # _____ Date: 2014

Approx. NAD ²⁹~~83~~ Geographic Position: Latitude 43° 39' 02" Longitude 123° 36' 32"

DESCRIPTION and TO REACH

A 4 INCH DIAMETER USGS DISK STAMPED
" B 133 B 1919 " SET NEAR THE HIGHEST POINT
OF A PARTIALLY BURIED BOULDER, THE LARGEST DIMENSION
OF WHICH IS APPROXIMATELY 45 FEET, AND WHICH PROTRUDES
APPROXIMATELY 3 FEET ABOVE GROUND.

FROM THE INTERSECTION OF STATE HIGHWAY 138
AND STATE HIGHWAY 38 IN T22S, R7W, SECTION 29
PROCEED NORTHWESTERLY ALONG STATE HIGHWAY 38 APPROX-
IMATELY 2.45 MILES TO MILE POINT 33.7 AND MONUMENT TO RIGHT
APPROXIMATELY 250 FT NORTHERLY FROM ROAD.

Reference Marks:

