


OFFICE OF THE
DOUGLAS COUNTY SURVEYOR

Station: U61 T 22 S, R 8 W , Sec 21
Set By (Agency): DCSO
Date Set: 1972
Recovered By RWS, SJF
Date Recovered 4/28/87; 10/98
Recovered By _____
Date Recovered _____
Recovered By _____
Date Recovered _____

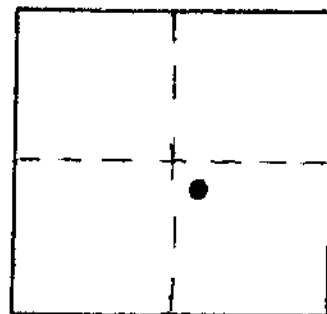

u-062
U 61
22S 8W 21

NAD 735661.91 4086878.09
83 43°38'32" 123°39'10"

VERTICAL CONTROL

Elevation: 125²⁶ NGS Line # _____ USGS Line # _____ OSHD Line # _____
Precision: 3rd Agency: DCSO Proj. # CS66/52 Date: 10/98

HORIZONTAL CONTROL

South Zone State Plane Coordinates: Y(Northing) 735,696.77 X(Easting) 1,165,917.82
Precision: 1/10,000 Agency: DCSO Proj. # 2006 Date: 1972
Approximate Geographic Position: Latitude 43°38'32" Longitude 123°39'06"


DESCRIPTION and TO REACH

SKETCH

A DCSO disk stamped "U61 1972" set in an
8 in. dia. concrete filled belltile protruding
5 in. above ground.

TO REACH:

From the intersection of Bridge Rd.
(BLM Rd. #22-8-29.1) and Henderer Rd.
(Co. Rd. #118) in T22S, R8W, Sec.29,
proceed northeasterly along Henderer Rd.
approx. 0.95 miles to sharp bend in
road and monument on left.

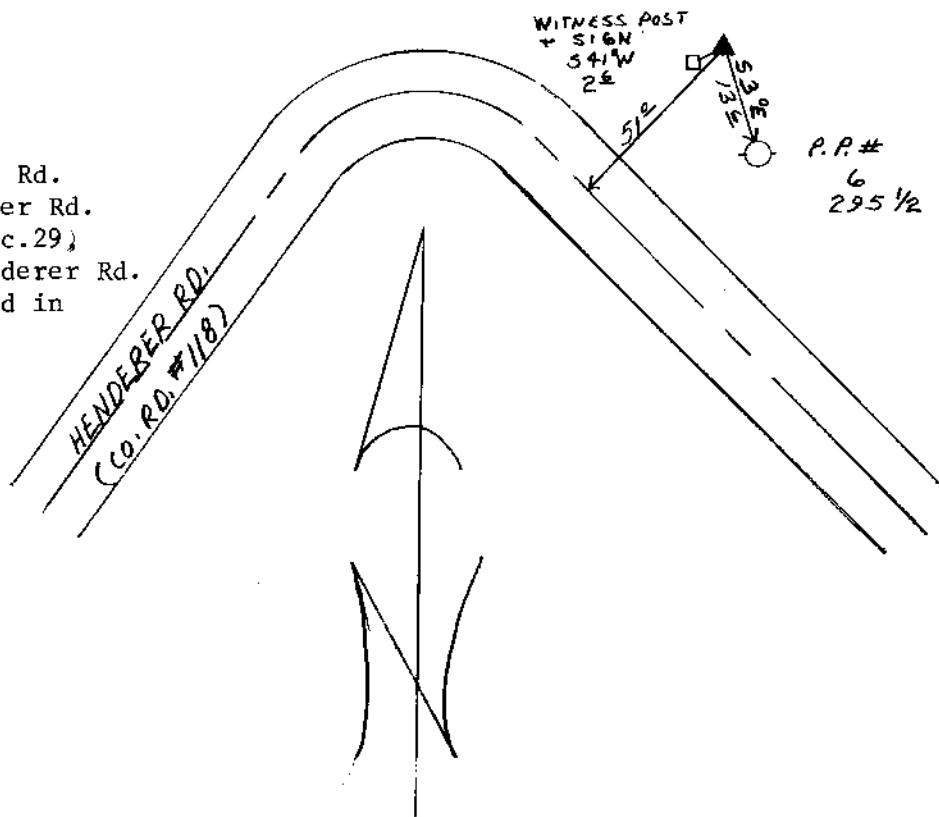

Reference Marks:

Note: For further information, contact the Douglas County Surveyor's Office, Room 205
Douglas County Justice Building, Roseburg, OR 97470. Phone 440-4278. Douglas
County residents outside the Roseburg calling area, dial toll free 1-800-452-0991.