
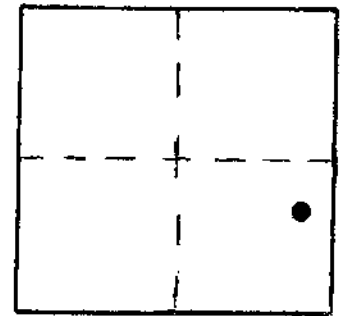


OFFICE OF THE
DOUGLAS COUNTY SURVEYOR

Station: ~~U59~~ U59 T 22 S, R 8 W, Sec 22
 Set By (Agency): DCSO
 Date Set: 1972
 Recovered By RWS, SJF
 Date Recovered 4/28/87 10/89
 Recovered By _____
 Date Recovered _____
 Recovered By _____
 Date Recovered _____

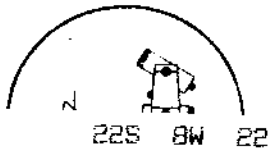

U-060
U 59

NAD 734889.27 4093632.78
83 43°38'27" 123°37'38"

VERTICAL CONTROL

Elevation: 11874 NGS Line # _____ USGS Line # _____ OSHD Line # _____
 Precision: 3rd Agency: DCSO Proj. # CS 66/52 Date: 10/98

HORIZONTAL CONTROL

South Zone State Plane Coordinates: Y(Northing) 734,924.15 X(Easting) 1,172,672.52
 Precision: 1/10,000 Agency: DCSO Proj. # 2006 Date: 1972
 Approximate Geographic Position: Latitude 43°38'27" Longitude 123°37'33"

DESCRIPTION and TO REACH

SKETCH

A DCSO disk stamped "U59 1972" set in an 8 in. dia. concrete filled belltile protruding 8 in. above ground, and approx. 3 ft. lower than road at edge of field.

TO REACH:

From the intersection of Mehl Creek Rd.
 (Co. Rd. #11) and Henderer Rd.
 (Co. Rd. #118) in T22S,R7W, Sec. 30,
 proceed westerly along Henderer Rd.
 approx. 3.10 miles to monument on right.

