

OFFICE OF THE
DOUGLAS COUNTY SURVEYOR

Station: Y 287 T 22 S, R 9 W , Sec 17

Set By (Agency): OSHD

Date Set: 1940

Recovered By GEQ


Date Recovered 2/17/82

Recovered By _____


Date Recovered _____

Recovered By _____

Date Recovered _____

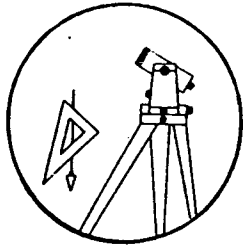

Y-002

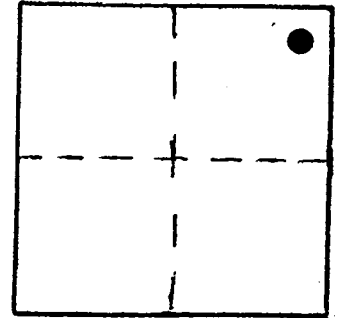

VERTICAL CONTROL NGVD 29

Elevation: 55.574 NGS Line # 16 USGS Line # _____ OSHD Line # _____

Precision: 1st Agency: USC&GS Proj. # _____ Date: 1961

HORIZONTAL CONTROL CORPSCON6 NAVD 88 59.153 FT.

South Zone State Plane Coordinates: Y(Northing) 744806 X(Easting) 4051224

Precision: GIS SCALED Agency: DCSO Proj. # _____ Date: 2014

Approximate Geographic Position: Latitude 43° 39' 47" Longitude 123° 47' 14"


DESCRIPTION and TO REACH

SKETCH

Station is a standard OSHD disk, set in concrete post flush with ground, stamped "Y 287 1940".

To reach from the intersection of Hwy 38 and Vincent Cr. Road # 22-9-7.0 (in S. 7, T 22 S, R 9 W), proceed easterly along Hwy 38 1.40 mi. to station on left.

→ WELLS CR RD?

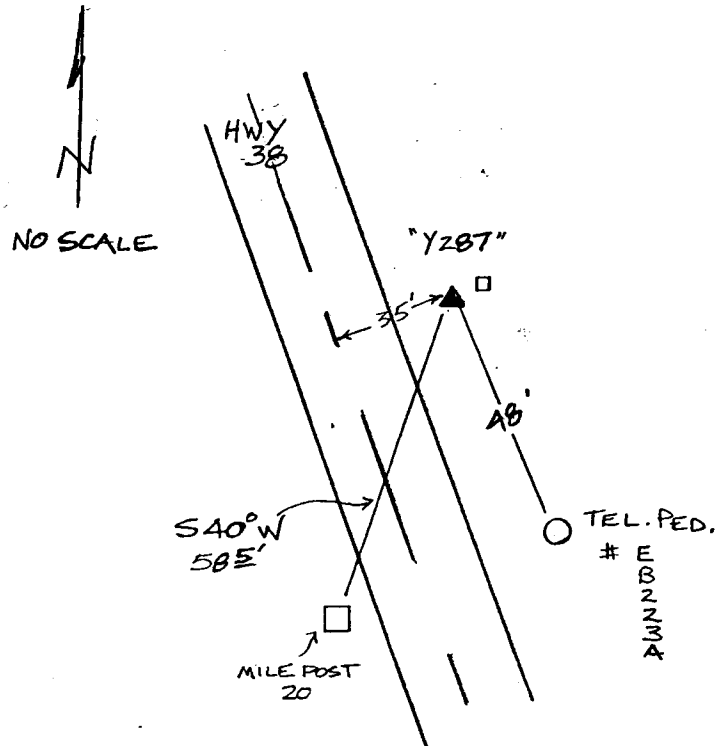

Reference Marks:

Note: For further information, contact the Douglas County Surveyor's Office, Room 205 Douglas County Justice Building, Roseburg, OR 97470. Phone 440-4278. Douglas County residents outside the Roseburg calling area, dial toll free 1-800-452-0991.