

OFFICE OF THE
DOUGLAS COUNTY SURVEYOR



u-081
U-78

225 10W 14

NAD 743216.96 4030446.99
83 43°39'25" 123°52' 1"

U-081

VERTICAL CONTROL **NGVD 29**

Elevation: 34.23 NGS Line # USGS Line # OSHD Line #
Precision: 3rd Agency: DCSO Proj. # 2006 Date: 1972

HORIZONTAL CONTROL **NAD 27**


South Zone State Plane Coordinates: Y(Northing) 743,251.65 X(Easting) 1,109,486.61
Precision: 1/10,000 Agency: DCSO Proj. # 2006 Date: 1973
Approximate Geographic Position: Latitude 43°39'25" Longitude 123°51' 57"

DESCRIPTION and TO REACH

Found: Standard DCSO disk set in boulder stamped
"U-78 1973".

To reach: From the intersection of Hwy. #38 & Co. Rd. #3 (in sec. 15 T22S R10W), proceed Easterly along Hwy. #38 0.5 mi. to monument on the left.

SKETCH

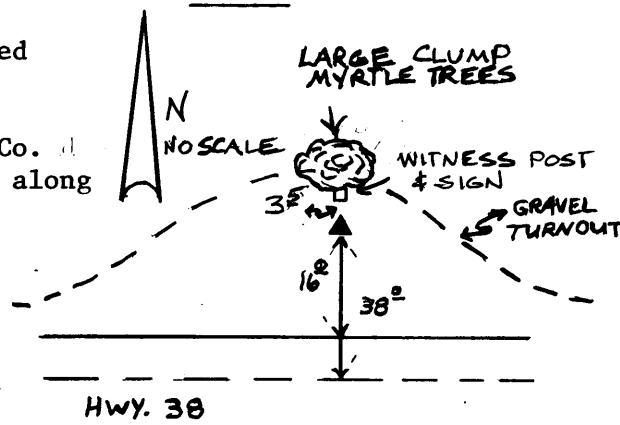

Reference Marks:

Note: For further information, contact the Douglas County Surveyor's Office, Room 205 Douglas County Justice Building, Roseburg, OR 97470. Phone 440-4278. Douglas County residents outside the Roseburg calling area, dial toll free 1-800-452-0991.