

OFFICE OF THE
DOUGLAS COUNTY SURVEYOR

Station: U-81 T 22 S, R 10W, Sec 17

Set By (Agency): DCSO

Date Set: 1973

Recovered By GQ-RS



Date Recovered 2-16-82

Recovered By _____

Date Recovered _____

Recovered By _____

Date Recovered _____

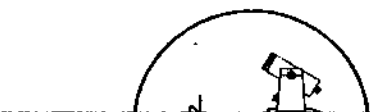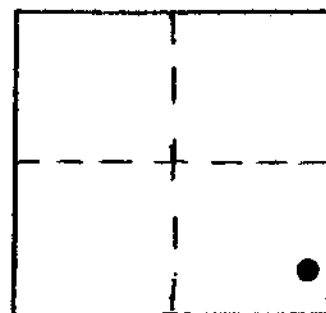

u-024 22S 10W 17
U-81

NAD 742667.18 4018900.19
83 43°39'14" 123°54'38"

VERTICAL CONTROL

Elevation: 22.25 NGS Line # _____ USGS Line # _____ OSHD Line # _____

Precision: 3rd Agency: DCSO Proj. # 2006 Date: 1972

HORIZONTAL CONTROL

South Zone State Plane Coordinates: Y(Northing) 742,701.80 X(Easting) 1,097,939.84

Precision: 1/10,000 Agency: DCSO Proj. # 2006 Date: 1973


Approximate Geographic Position: Latitude 43°39'15" Longitude 123°54'34"

DESCRIPTION and TO REACH

SKETCH

Found: A standard DCSO disk set in boulder stamped "U-81 1973".

To reach: From the intersection of Hwy 38 & Co.Rd. #3 (in sec. 15 T22S R10W) proceed westerly along Hwy.#38 1.95 miles to monument on the right.

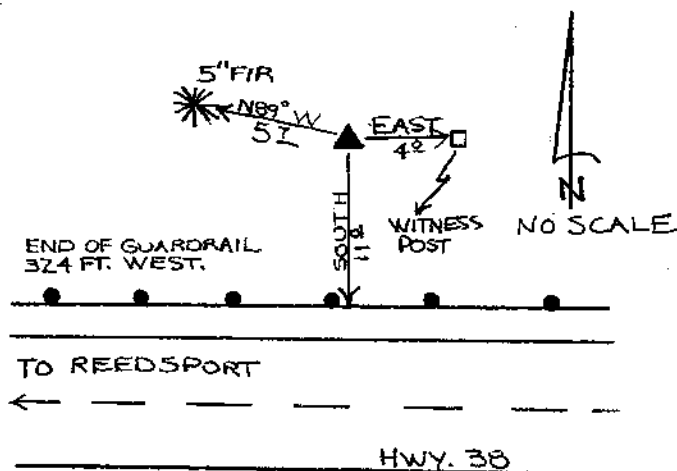

Reference Marks:

Note: For further information, contact the Douglas County Surveyor's Office, Room 205 Douglas County Justice Building, Roseburg, OR 97470. Phone 440-4278. Douglas County residents outside the Roseburg calling area, dial toll free 1-800-452-0991.