


225 12W 7

OFFICE OF THE

DOUGLAS COUNTY SURVEYOR

NAD	754571.18	3949228.15
83	43°40'43"	124°10'32"

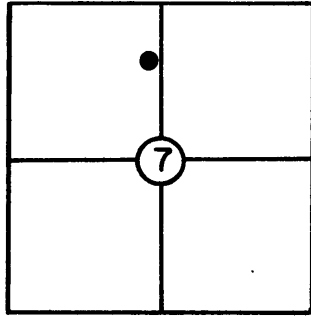

T 22 S, R 12 W., Sec. 7

Station: JENIFER

Set By (Agency): DCSO

Date: 1980

VERTICAL CONTROL NGVD 29

Elevation:	9.464	NGS(USC&GS) Line #	USGS Line #
------------	-------	--------------------	-------------

Order
Of Precision 2nd Agency: DCSO Proj. #: 2007 CS 61/16 Date: 1981

HORIZONTAL CONTROL NAD 27

Oregon State Plane Coordinates: Y(Northing) 754,606.20 X(Easting) 1,028,267.48
(South Zone)

Order _____ CS 61/16
Of Precision 1/15,000 Agency: DCSO Proj. #: 2008 Date: 1980

Approximate Geographic Position: Latitude= 43° 40' 43" Longitude= 124° 10' 28"

DESCRIPTION: From intersection of 9th Blvd.

and Beach Ave. go 0.3 mi. on Beach Ave.


to sta. Mon. is a DCSO BC set in conc.

sidewalk. (See sketch). Pt. is on W. side

of street.

VICINITY: Salmon Harbor (Winchester Bay)

SKETCH

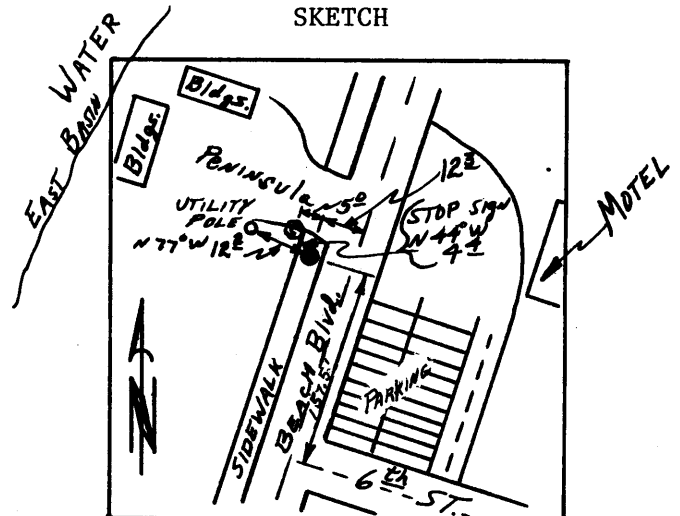

NOTE: For Possible Further Information On This Station, Please Contact The Douglas County Surveyors Office, Rm. 205 Douglas County Justice Bldg., Roseburg, OR. 97470 Phone 672-3311 Ext. 272.. Douglas County residents outside the Roseburg calling area dial toll free 1-800-452-0991.