



write/rain C-154 GPS
 OFFICE OF THE C
 DOUGLAS COUNTY SURVEYOR

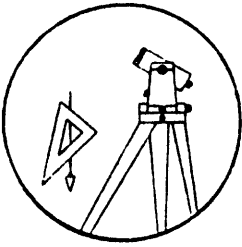

Station: WY4 S. 2
 Date Set: 1978
 Set By (Agency): DCSO
 Date Recovered: 2-11-97
 Recovered By: RWS SJF

T 23 S, R 4W, Sec 3
 PLSS 500640

- Found
- Reset
- Referenced
- New
- Not Found
- Destroyed

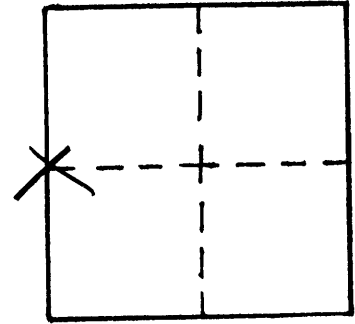

VERTICAL CONTROL

Elevation: 875.04 NGS Line # _____ USGS Line # _____ OSHD Line # _____
 Precision: 3rd Agency: DCSO Proj. # 2007 Date: 1997
CS 66/54

HORIZONTAL CONTROL

South Zone O.C.S. 27: Y(Northing) _____ X(Easting) _____
 South Zone O.C.S. 83: Y(Northing) _____ X(Easting) _____
 Precision: _____ Agency: _____ Proj. # _____ Date: _____
 Approx. NAD ~~83~~ Geographic Position: Latitude 43°35'55" Longitude 123°08'45"

DESCRIPTION and TO REACH

SEE DCSO CORNER RENEWAL RECORDS

2 1/2" BRASS CAP ON A 1 1/2" OP. I.P.
PROTRUDES 2" ABOVE GROUND.

FROM THE INTERSECTION OF SCOTTS VALLEY RD
(CO. RD # 8) AND LONDON HILL RD (CO. RD 8A)
IN T23S R4W SEC. 3 PROCEED SOUTHERLY
ALONG SCOTTS VALLEY RD 0.35 MILES
TO MONUMENT ON LEFT

Reference Marks:

