


write/rain P-113 POS GPS


OFFICE OF THE
DOUGLAS COUNTY SURVEYOR

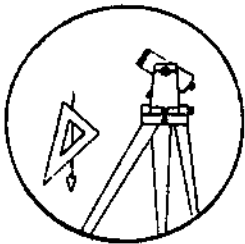

Station: POM
Date Set: 1997
Set By (Agency): DCSG
Date Recovered: 2-19-97
Recovered By: RWS, STF

☒ Found ☒ New
☐ Reset ☐ Not Found
☐ Referenced ☐ Destroyed

T 23 S, R 4W, Sec 10

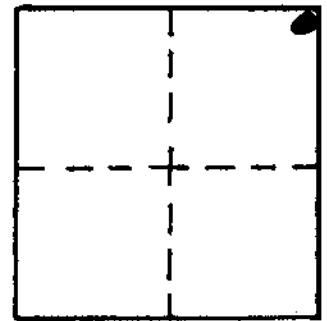

VERTICAL CONTROL NGVD 29

Elevation: 884.80 NGS Line # _____ USGS Line # _____ OSHD Line # _____

Precision: 3rd Agency: DCSG Proj. # 2007 Date: 1997

HORIZONTAL CONTROL

CS 66/54

South Zone O.C.S. 27: Y(Northing) _____ X(Easting) _____

South Zone O.C.S. 83: Y(Northing) _____ X(Easting) _____

Precision: _____ Agency: _____ Proj. # _____ Date: _____

Approx. ~~NAD 83~~ Geographic Position: Latitude 43°35'29" Longitude 123°08'47"

DESCRIPTION and TO REACH

8" DIA. BY 42" LONG CONCRETE FILLED BELL TILE
WITH A DCSG BRASS CAP STAMPED "POM 1997"
PROTRUSING 3" ABOVE GROUND

FROM THE INTERSECTION OF SCOTTS VALLEY RD
(CO. RD #29) AND LONDON RD (CO. RD #8A) IN T23S
R4W SEC 3, PROCEED SOUTHERLY ALONG
SCOTTS VALLEY ROAD 0.9 MILES TO BARN AND
MONUMENT ON LEFT.

Reference Marks:

