

OFFICE OF THE H-067

DOUGLAS COUNTY SURVEYOR

Station: HOWARD

T 23 S, R 4W, Sec 33



Date Set: 1997

Set By (Agency): DCSO

Date Recovered: 2-26-97

Recovered By: RKS SJF

- Found
- New
- Reset
- Not Found
- Referenced
- Destroyed

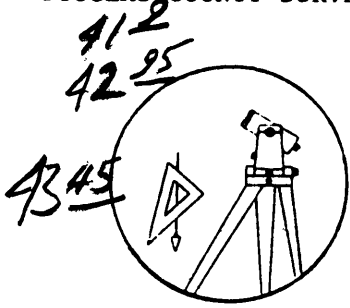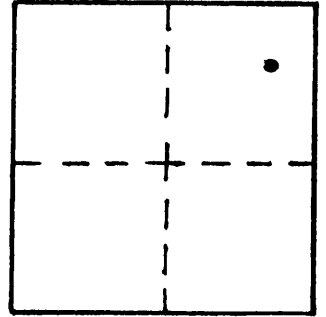

VERTICAL CONTROL NGVD 29

Elevation: 911.27 NGS Line # _____ USGS Line # _____ OSHD Line # _____

Precision: 3rd Agency: DCSO Proj. # 2007 Date: 1997

HORIZONTAL CONTROL

CS66154

South Zone O.C.S. 27: Y(Northing) _____ X(Easting) _____

South Zone O.C.S. 83: Y(Northing) _____ X(Easting) _____

Precision: _____ Agency: _____ Proj. # _____ Date: _____

Approx. 27 Geographic Position: Latitude 43° 31' 51" Longitude 123° 10' 04"

DESCRIPTION and TO REACH

"HOWARD 1997"

6" INSIDE DIA. BY 36" LONG CONCRETE
FILLED CORRUGATED PLASTIC PIPE. PROTRUS
3" ABOVE GROUND.

FROM THE INTERSECTION OF ROMIE HOWARD ROAD
CO. RD #69 AND SCOTTS VALLEY ROAD (CO. RD #8)
IN T23 R5W SEC. 21 PROCEED SOUTHERLY ALONG
SCOTTS VALLEY ROAD 1.55 MILES TO MINUMENT
ON RIGHT.

Reference Marks:

