


OFFICE OF THE

DOUGLAS COUNTY SURVEYOR

U-048
U-46

23S 7W 8

NAD 713790.30 4111572.53
83 43°35' 5" 123°33'24"

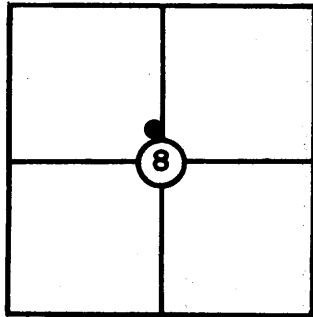

T 23 S, R 7W, Sec. 8

Station: U-46

Set By (Agency): DCSO

Date: 1972

NGVD 29

U-048

VERTICAL CONTROL

Elevation: 190.29 ~~190.291~~ NGS(USC&GS) Line # _____ USGS Line # _____

Order
Of Precision 3rd Agency: DCSO Proj. #: 2006 Date: 1972

HORIZONTAL CONTROL

DCS 27

Oregon State Plane Coordinates: Y(Northing) 713,825.18 X(Easting) 1,190,612.52
(South Zone)

Order
Of Precision 1/10,000 Agency: DCSO Proj. #: 2006 Date: 1972

Approximate Geographic Position: Latitude= 43°35'05" Longitude= 123°33'20"

DESCRIPTION: Bronze disk set in concrete

bell tile with survey marker alongside.


Station is on road shoulder of Hwy. and

private drive. 110 ft. S. of bridge.

VICINITY: From the junction of Tyee Rd. and

Hwy. 138 go W'stly 9.5 mi.

SKETCH

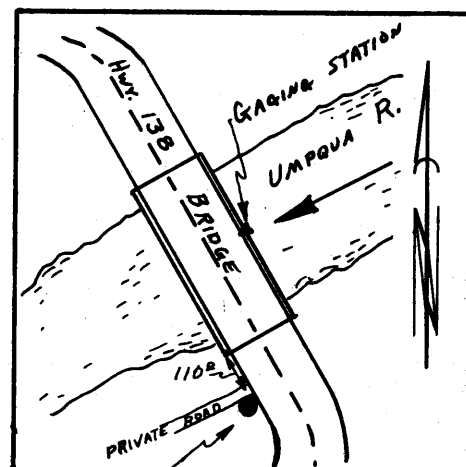

Sta. on Rd. shoulders of
Hwy. & Private Dr.

NOTE: For Possible Further Information On This Station, Please Contact The Douglas County Surveyors Office, Rm. 205 Douglas County Justice Bldg., Roseburg, OR. 97470 Phone 672-3311 Ext. 272.. Douglas County residents outside the Roseburg calling area dial toll free 1-800-452-0991.