


OFFICE OF THE

DOUGLAS COUNTY SURVEYOR

u-047
U-45

23S 7W 17

NAD 708123.98 4111783.14
83 43°34' 9" 123°33'18"

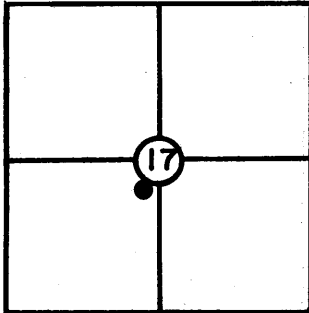

T 23 S, R 7W, Sec. 17

Station: U-45

Set By (Agency): DCSO

Date: 1972

NGVD 29

U-047

VERTICAL CONTROL

Elevation: 512.00
~~512.001~~ NGS(USC&GS) Line # _____ USGS Line # _____

Order
Of Precision 3rd Agency: DCSO Proj. #: 2006 Date: 1972

HORIZONTAL CONTROL

OCS 27

Oregon State Plane Coordinates: Y(Northing) 708,158.83 X(Easting) 1,190,823.22
(South Zone)

Order
Of Precision 1/10,000 Agency: DCSO Proj. #: 2006 Date: 1972

Approximate Geographic Position: Latitude= 43°34'10" Longitude= 123°33'14"

DESCRIPTION: Bronze disk set in concrete

belltile, survey marker alongside.

Sta. is in old hwy. about 10 ft. from E.

edge of new rd. and approx. 70 ft. N.


of Kesterson Rd. Sta. is 350 ft. N. of Summit

of Rd.

VICINITY: From the junction of Tye Rd.

and Hwy. 138 proceed W'stly 8.3 mi.

SKETCH

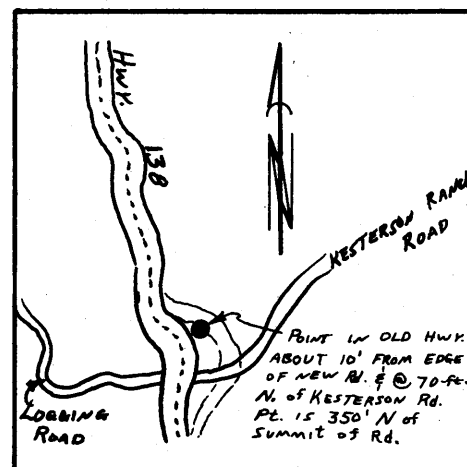

NOTE: For Possible Further Information On This Station, Please Contact The Douglas County Surveyors Office, Rm. 205 Douglas County Justice Bldg., Roseburg, OR. 97470 Phone 672-3311 Ext. 272.. Douglas County residents outside the Roseburg calling area dial toll free 1-800-452-0991.