


DOUGLAS COUNTY SURVEYOR

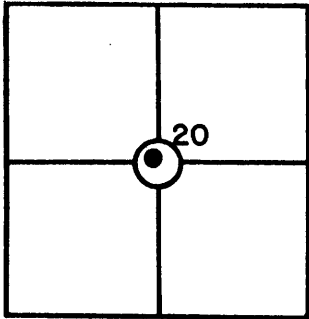

T-008

T 23 S, R 7W, Sec. 20

Station: T 335

Set By (Agency): USC & GS

Date: 1934

SJF, JAP 9/2006

VERTICAL CONTROL

NGVD 29

Elevation: 204.892 NGS(USC&GS) Line # 326 USGS Line #

Order

Of Precision 2nd Agency: USC & GS Proj. #: _____ Date: 1942

HORIZONTAL CONTROL

Oregon State Plane Coordinates: Y(Northing) _____ X(Easting) _____
(South Zone)

Order

Of Precision _____ Agency: _____ Proj. #: _____ Date: _____

Approximate Geographic Position: Latitude= _____ Longitude= _____

DESCRIPTION: About 0.1 mi. N. of Kellogg

on Elkton Hwy. Bronze cap in N. end of bridge


piling of the now destroyed bridge.

Monument bears aprox. S 19*W, 43 ft.

from NW corner of bridge.

VICINITY: Approx. 0.1 mi. N. of Kellogg.

SKETCH

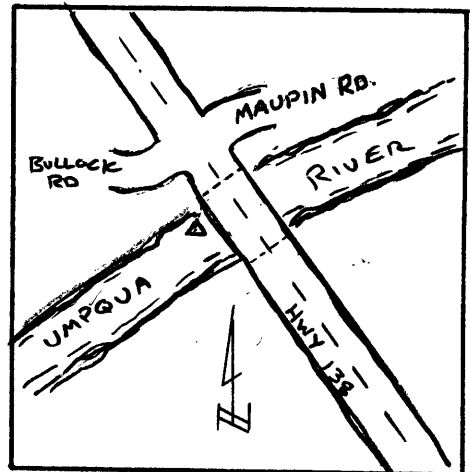

NOTE: For Possible Further Information On This Station, Please Contact The Douglas County Surveyors Office, Rm. 205 Douglas County Justice Bldg., Roseburg, OR. 97470 Phone 672-3311 Ext. 272.. Douglas County residents outside the Roseburg calling area dial toll free 1-800-452-0991.