


2/82

p-008
P 266

24S 5W 32

OFFICE OF THE

DOUGLAS COUNTY SURVEYOR

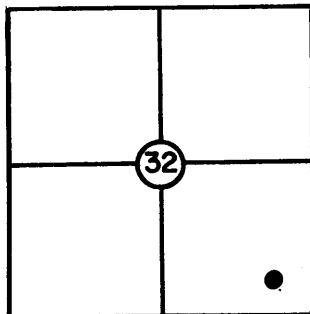NAD 657336.23 4174669.65
83 43°26' 9" 123°18'41"T 24 S, R 5W, Sec. 32Station: P 266Set By (Agency): USC & GSDate: 1934VERTICAL CONTROLNGVD 29 433.84

OSHD

Elevation: ~~433.839~~ NGS (USC&GS) Line # 369 USGS Line # Order
Of Precision 3rd Agency: OSHD Proj. #: Date: 1977HORIZONTAL CONTROL


OCS 27

Oregon State Plane Coordinates: Y(Northing) 657,370.66 X(Easting) 1,253,710.23
(South Zone)Order
Of Precision 1/25,000 Agency: DCSO Proj. #: 2006 Date: 1981

(Calapooya)

Approximate Geographic Position: Latitude= 43° 26' 10" Longitude= 123° 18' 37"DESCRIPTION: In the NW cor. of hwy. culverttop of headwall and opposite SPRR culvert590.31. A standard disk stamped "433 p 266
1934".Note: there is another monument on this
headwall.VICINITY: Approx. 1 mi. N. of Oakland.

SKETCH

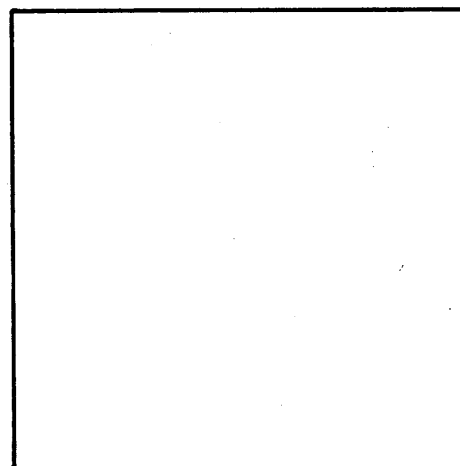

NOTE: For Possible Further Information On This Station, Please Contact The Douglas County Surveyors Office, Rm. 205 Douglas County Justice Bldg., Roseburg, OR. 97470 Phone 672-3311 Ext. 272.. Douglas County residents outside the Roseburg calling area dial toll free 1-800-452-0991.