


OFFICE OF THE
DOUGLAS COUNTY SURVEYOR

Station: KID T 25 S, R 4 W, Sec 2
Set By (Agency): SCS
Date Set: 1975
Recovered By RWS, SJF
Date Recovered 3/6/87
Recovered By _____
Date Recovered _____
Recovered By _____
Date Recovered _____

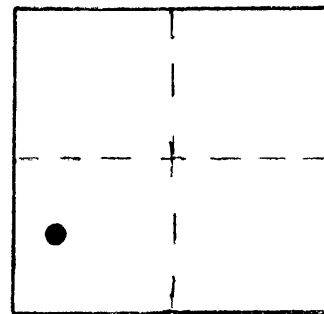

K-027

VERTICAL CONTROL NGVD 29

Elevation: 764.112 NGS Line # _____ USGS Line # _____ OSHD Line # _____
Precision: 3rd Agency: DCSO Proj. # 6011-1, (CS57/25) Date: 1975

HORIZONTAL CONTROL NAD 27

South Zone State Plane Coordinates: Y(Northing) 650,686.73 X(Easting) 1,297,388.95
Precision: 1/25,000 Agency: DCSO Proj. # 6011-1, (CS57/25) Date: 1975
Approximate Geographic Position: Latitude 43°25'18" Longitude 123°08'42"


DESCRIPTION and TO REACH

AN SCS disk stamped "KID SCS" set in and 8 in. dia. concrete filled belltile, protrudes 3 in. above ground.

TO REACH:

From the intersection of Nonpariel Rd.
(Co. Rd. #19) and Gassy Creek Rd. (BLM Rd.
#25-4-2.0) in T25S, R4W, Sec. 2, proceed westerly along
Nonpariel Rd. 0.85 miles to monument of right.

Reference Marks:

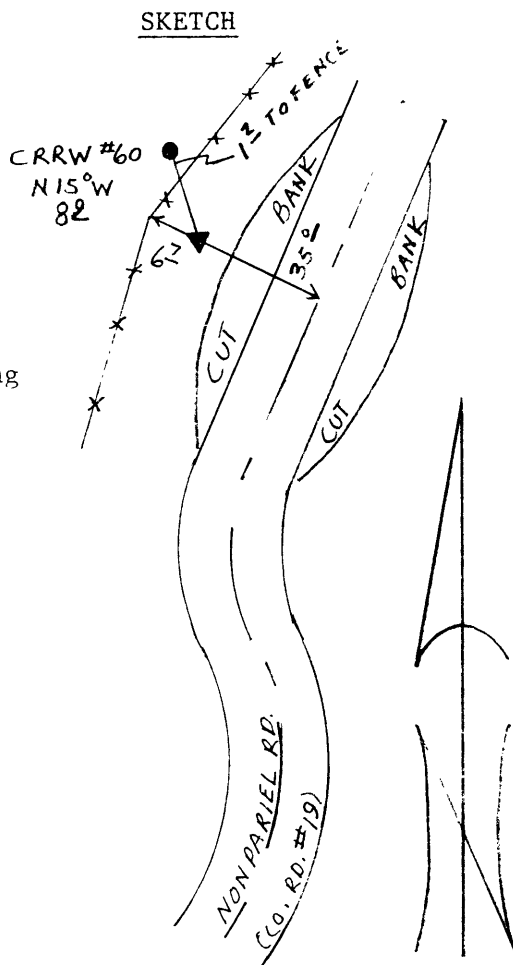

Note: For further information, contact the Douglas County Surveyor's Office, Room 205 Douglas County Justice Building, Roseburg, OR 97470. Phone 440-4278. Douglas County residents outside the Roseburg calling area, dial toll free 1-800-452-0991.