

Douglas County Geodetic Data Sheet


Station: PTS 9 = L 10

Designation: P-111

T 25 R 05 S 04

Date Set: 1917 Set By (Agency): USGS

Last Date Recovered: 09/19/93

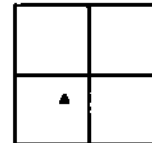

VERTICAL CONTROL

NGVD 29 Elevation: 430.173 Feet

Precision: 1ST ORDER Agency: USGS

Project:

Date: 1988

NAVD 88 Elevation: 132.189 Meters

Precision: Agency:

Project:

Date:

NGS Line # USGS Line #

OSHD Line #

File #

HORIZONTAL CONTROL

OCS 27 Y(Northing): 652,114.56 X(Easting): 1,256,720.07 Lat

Long:

Precision: 1/25,000 Agency: DCSO

Project: 2006

Date: 1981

OCS 83 Y(Northing): 652,080.03 X(Easting): 4,177,679.40 Lat: 43°25'18"

Long: 123°17'58"

Precision: Agency:

Project:

Date:

OCS 83/91 Y(Northing): X(Easting): Lat:

Long:

Precision: Agency:

Project:

Date:

OCS 27 Scaled Latitude: 43°25'19"


OCS 27 Scaled Longitude: 123°17'54"

DESCRIPTION:

A 4 INCH DIAMETER USGS DISK STAMPED; PRIM TRAV STA NO 9 429 L 10 B 1903 1917; SET IN CONCRETE APPROXIMATELY 2 INCHES BELOW MOWN LAWN SURFACE.

COMMENTS:

GO TO THE INTERSECTION OF STATE HWY 99 AND LOCUST ST IN T25S R5W SEC 4 IN OAKLAND. MONUMENT IS WESTERLY OF INTERSECTION IN SMALL PARK.

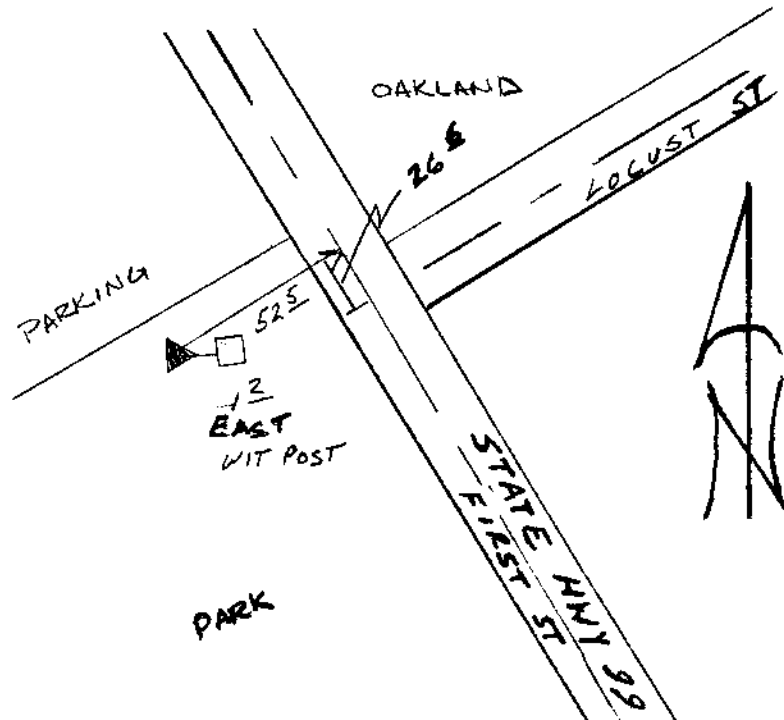

Note: For further information contact the Douglas County Surveyors Office, Room 105A Douglas County Courthouse, Roseburg, OR 97470. Phone 440-4272 or Fax (541)957-8150. Douglas County Residents outside Roseburg calling area, dial toll free 1-800-224-1619.