


2/13/81

OFFICE OF THE

DOUGLAS COUNTY SURVEYOR

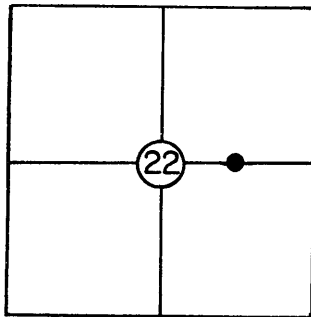

X-009

VERTICAL CONTROL

NGVD 29

Elevation: 410.728 NGS(USC&GS) Line # 98 USGS Line # _____

Order

Of Precision 2nd Agency: USC & GS Proj. #: _____ Date: 1957

HORIZONTAL CONTROL

NAD 27

Oregon State Plane Coordinates: Y(Northing) 638,227.40 X(Easting) 1,232,157.61
(South Zone)

Order

(Calapooya)

Of Precision 1/25,000 Agency: DCSO Proj. #: 2006 Date: 1981

Approximate Geographic Position: Latitude= 43° 22' 54" Longitude= 123° 23' 20"

DESCRIPTION: NEAR A POINT WHERE THE ROAD

CURVES N. THROUGH A DEEPCUT AND GOES DOWN

HILL 35 FT. S. OF CENTERLINE OF RD. 2 FT.

N. OF FENCE LINE A STANDARD DISK STAMPED


"X495 1942" SET IN TOP OF A CONCRETE

POST.

VICINITY: 4.0 MI. W. ALONGSIDE THE UMPQUA

RD. FROM SPRR AT SUTHERLIN.

SKETCH

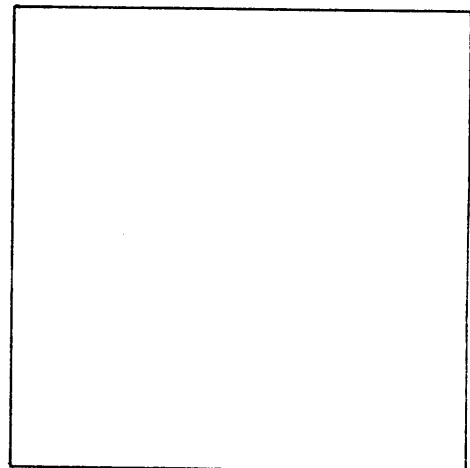

NOTE: For Possible Further Information On This Station, Please Contact The Douglas County Surveyors Office, Rm. 205 Douglas County Justice Bldg., Roseburg, OR. 97470 Phone 672-3311 Ext. 272. Douglas County residents outside the Roseburg calling area dial toll free 1-800-452-0991.