

2/82


OFFICE OF THE

j-006
J 496

25S 6W 29

DOUGLAS COUNTY SURVEYOR

NAD	634120.50	4139880.11
83	43°22' 8"	123°26'22"

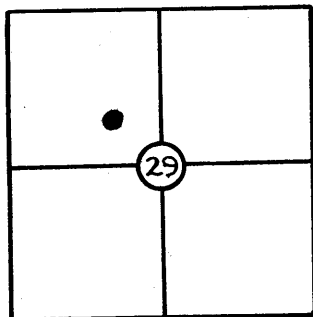T 25 S, R 6 W, Sec. 29Station: J 496Set By (Agency): USC&GSDate: 1942VERTICAL CONTROL

~~NAD 29~~
Elevation: 388.559 NGS(USC&GS) Line # 98 USGS Line # _____

Order
Of Precision 2nd Agency: USC&GS Proj. #: _____ Date: 1957

HORIZONTAL CONTROL

~~NAD 27~~
Oregon State Plane Coordinates: Y(Northing) 634,155.19 X(Easting) 1,218,921.24
(South Zone)

Order
Of Precision 1/25,000 Agency: DCSO Proj. #: 2006 Date: 1981
(Calapooya)


Approximate Geographic Position: Latitude= 43° 22' 09" Longitude= 123° 26' 17"

DESCRIPTION: Brass cap on South side of
the Sutherlin-Umpqua road (C.R. #9) at the
intersection of C.R. #9 and Cole road (C.R. #91).

Station lies 25' E'stly of Cole road sign
and 22' S'thly of centerline of road. Red
steel fence post & sign set 1' South of
station.

VICINITY: 1.5 mi. East of Umpqua

SKETCH

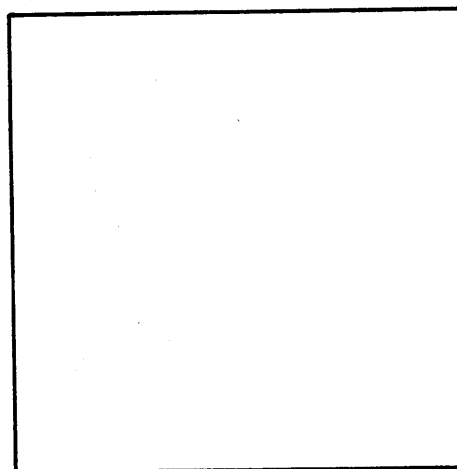

NOTE: For Possible Further Information On This Station, Please Contact The Douglas County Surveyors Office, Rm. 205 Douglas County Justice Bldg., Roseburg, OR. 97470 Phone 672-3311 Ext. 272.. Douglas County residents outside the Roseburg calling area dial toll free 1-800-452-0991.