



OFFICE OF THE
DOUGLAS COUNTY SURVEYOR

Station: TIGGER
Set By (Agency): DCSO
Date Set: 1980
Recovered By RWS, SJF
Date Recovered 12/01/88
Recovered By _____
Date Recovered _____
Recovered By _____
Date Recovered _____

T 25 S, R 6 W , Sec 30

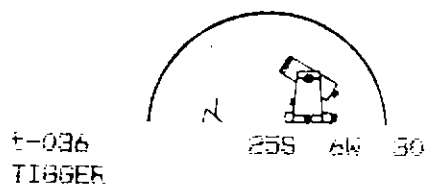

NAD 83 43°22' 21" 123°27'12"

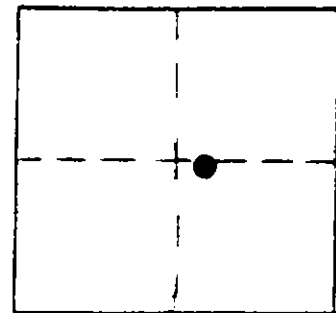

VERTICAL CONTROL

Elevation: 389.57 ft. NGS Line # _____ USGS Line # _____ OSHD Line # _____
Precision: 3rd Agency: DCSO Proj. # 2006 Date: 1981

HORIZONTAL CONTROL

South Zone State Plane Coordinates: Y(Northing) 633,628.93 X(Easting) 1,215,157.56
Precision: 1/25,000 Agency: DCSO Proj. # 2006 Date: 1981
Approximate Geographic Position: Latitude 43°22'02" Longitude 123°27'08"


DESCRIPTION and TO REACH

SKETCH

A DCSO disk stamped "TIGGER 1980" set in a
6 in. dia. concrete filled concrete tile protruding
approx. 4 in. above ground.

TO REACH:

Go to the intersection of Fort McKay Rd.
(Co.Rd.#9) and Tyee Rd. (Co.Rd.#33)
in T25S,R6W,Sec.30.

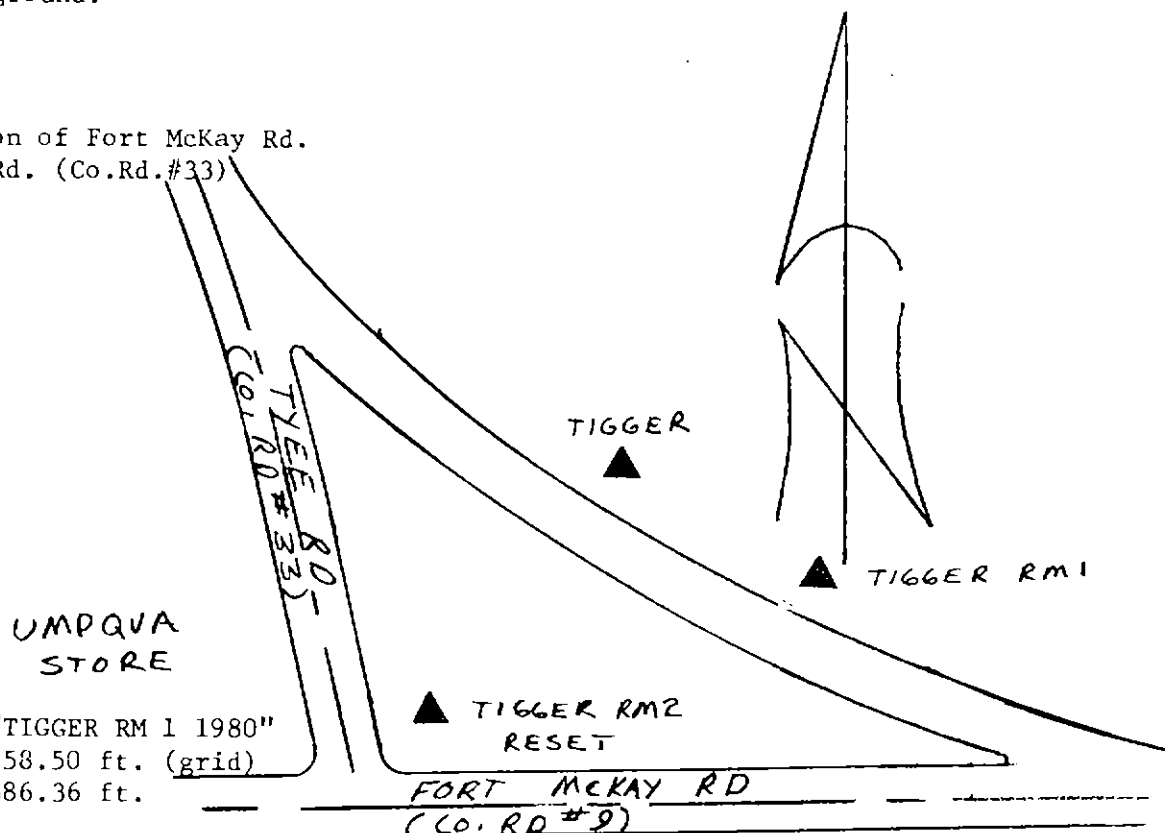

Reference Marks:

A DCSO disk stamped "TIGGER RM 1 1980"
bears S 61°19'13" E, 58.50 ft. (grid)
3rd order elevation 386.36 ft.

A DCSO disk stamped "TIGGER RM 2 RESET 1988"
bears S 32°17'43" W, 79.19 ft. (grid), 3rd order elevation 378.44 ft.

Note: For further information, contact the Douglas County Surveyor's Office, Room 205
Douglas County Justice Building, Roseburg, OR 97470. Phone 440-4278. Douglas
County residents outside the Roseburg calling area, dial toll free 1-800-452-0991.