

R033117A

DOUGLAS COUNTY SURVEYOR'S OFFICE

100-1115


Designation: G-060 Station: GW11-73 T 25S R 7W S 5 1/4 SW

Date Set: 1972

Set by (Agency): USGS

Date Recovered: 3-31-03

Recovered by: RWS SJF

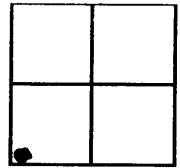

- Found
- New
- Reset
- Not Found
- Referenced
- Destroyed

VERTICAL CONTROL


NGVD 29 Elevation: 293.90 Feet File # C567/2  
 Precision: 3rd Agency: USGS Project: \_\_\_\_\_ Date: 1947  
 NAVD 88 Elevation: \_\_\_\_\_ Meters File # \_\_\_\_\_  
 Precision: \_\_\_\_\_ Agency: \_\_\_\_\_ Project: \_\_\_\_\_ Date: \_\_\_\_\_

HORIZONTAL CONTROL - south zone

N \_\_\_\_\_ E \_\_\_\_\_ Datum/Adj.: 1927 Precision: SCALED  
 Lat: 43°25'58" Long: 123°33'48" Agency: DCSO File # \_\_\_\_\_ Date: 2003  
 N \_\_\_\_\_ E \_\_\_\_\_ Datum/Adj.: \_\_\_\_\_ Precision: \_\_\_\_\_  
 Lat: \_\_\_\_\_ Long: \_\_\_\_\_ Agency: \_\_\_\_\_ File # \_\_\_\_\_ Date: \_\_\_\_\_  
DESCRIPTION AND TO REACH

FROM THE TYEE RD (CO. RD #32)  
AND TYEE ACCESS RD (BLM RD #257-511) IN  
T25S R7W SEC 5, CHECKED NORTHERLY  
ALONG TYEE ROAD 0.15 MILES  
TO MONUMENT ON RIGHT  
USGS BRASS CAP STAMPED  
"293 SWM 73 1942" SET  
IN AN 8" SQUARE CONCRETE  
POST PROTRUDING 1" FROM  
TOP SURFACE

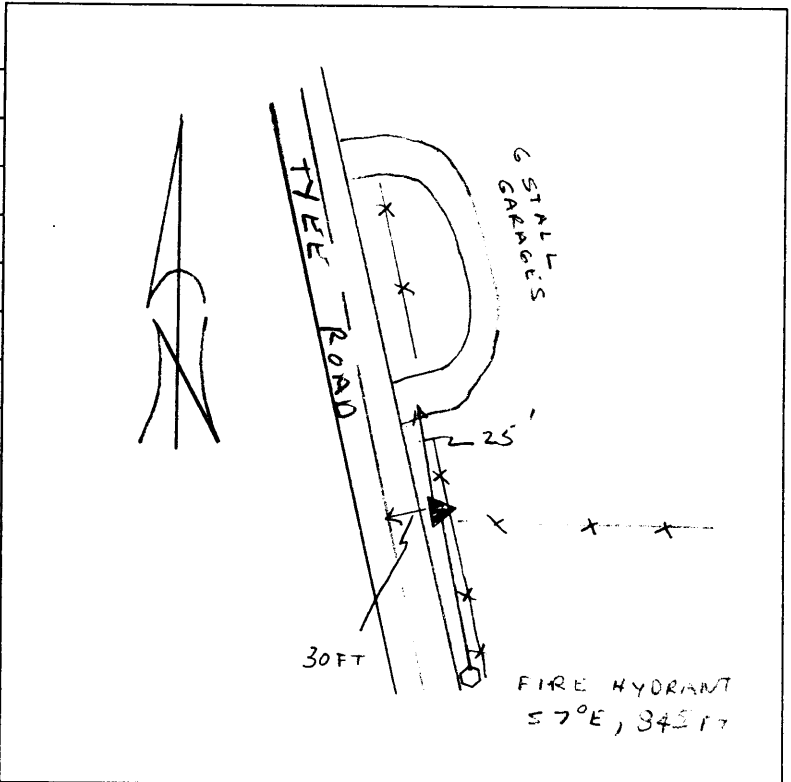



7. 28. 1999