



OFFICE OF THE
DOUGLAS COUNTY SURVEYOR

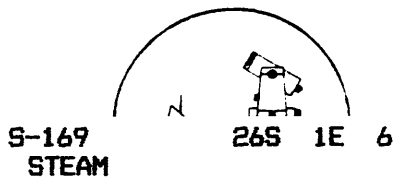

NAD 619081.19 4325949.61
83 43°20'37" 122°44'18"

Station: STEAM
Date Set: 1989
Set By (Agency): NGS
Date Recovered: 8-8-91
Recovered By: SJF
Date Recovered: _____
Recovered By: _____
Date Recovered: _____
Recovered By: _____

T 26 S, R 1E , Sec 6

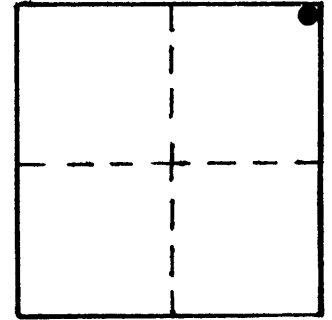

VERTICAL CONTROL NGVD 29

Elevation: 1189.6 NGS Line # _____ USGS Line # _____ OSHD Line # _____
Precision: GPS Agency: DCSO Proj. # 2008 Date: 1991


HORIZONTAL CONTROL

South Zone O.C.S. 27: Y(Northing) 619117.23 X(Easting) 1,404,989.36
South Zone O.C.S. 83: Y(Northing) _____ X(Easting) _____
Precision: 1/25,000 Agency: DCSO Proj. # GPS 27/83 Date: 1991
Approx. NAD 83 Geographic Position: Latitude _____ Longitude _____

DESCRIPTION and TO REACH

SKETCH

Found: A NGS GPS point set into a concrete mon. set 20 cm below the surface of the ground. Access is through an iron mon. cover.
To Reach: From the intersection of Hwy. 138 (Co. Rd.#200) and Steamboat Creek Rd. in T26S, R1E, sec. 6. Proceed easterly along Hwy 138 approx. 0.2 mi. to Wooden Arch Bridge over North Umpqua River follow road across bridge and up hill approx. 0.25 mi. to mon in OR DOT maintenance yard.

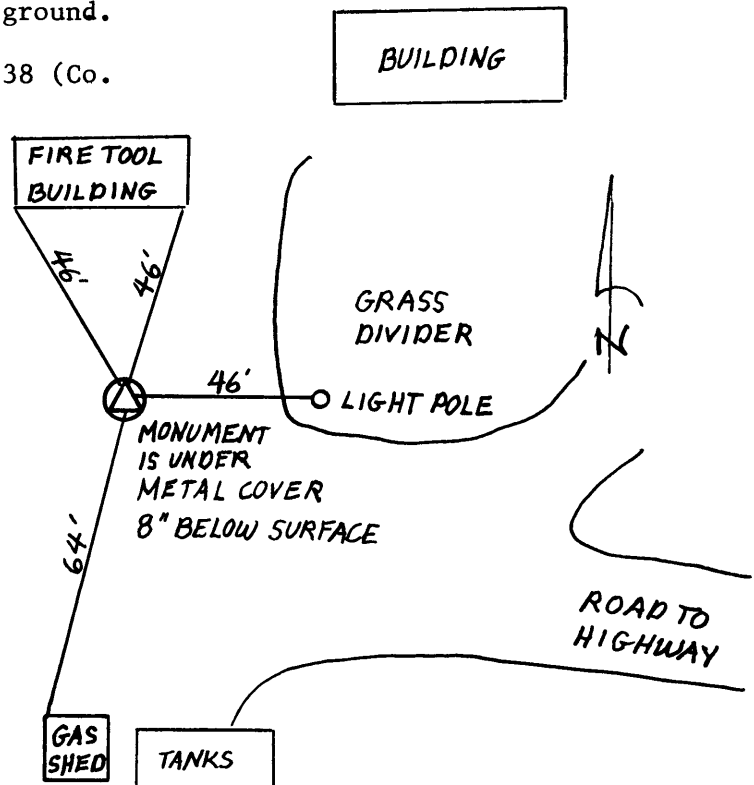

Reference Marks:

Note: For further information, contact the Douglas County Surveyor's Office, Room 205 Douglas County Justice Building, Roseburg, OR 97470. Phone 440-4278. Douglas County residents outside the Roseburg calling area, dial toll free 1-800-452-0991.