

OFFICE OF THE
DOUGLAS COUNTY SURVEYOR

Station: STEAM

T 26 S, R 1E , Sec 6

Date Set: 1989

Set By (Agency): NGS

Date Recovered: 8-8-91



Recovered By: SJF

Date Recovered: _____

Recovered By: _____

Date Recovered: _____

Recovered By: _____

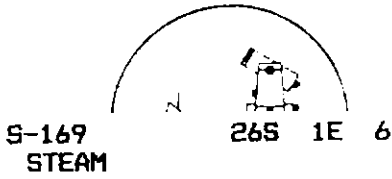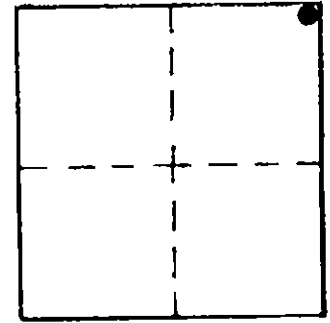

NAD 619081.19 4325949.61
83 43°20'37" 122°44'18"

VERTICAL CONTROL

Elevation: 1189.6 NGS Line # _____ USGS Line # _____ OSHD Line # _____

Precision: GPS Agency: DCSO Proj. # 2008 Date: 1991

HORIZONTAL CONTROL

South Zone O.C.S. 27: Y(Northing) 619117.23 X(Easting) 1,404,989.36

South Zone O.C.S. 83: Y(Northing) _____ X(Easting) _____


Precision: 1/25,000 Agency: DCSO Proj. # GPS 27/83 Date: 1991

Approx. NAD 83 Geographic Position: Latitude _____ Longitude _____

DESCRIPTION and TO REACH

Found: A NGS GPS point set into a concrete mon. set 20 cm below the surface of the ground. Access is through an iron mon. cover.
To Reach: From the intersection of Hwy. 138 (Co. Rd.#200) and Steamboat Creek Rd. in T26S, R1E, sec. 6. Proceed easterly along Hwy 138 approx. 0.2 mi. to Wooden Arch Bridge over North Umpqua River follow road across bridge and up hill approx. 0.25 mi. to mon in OR DOT maintenance yard.

SKETCH

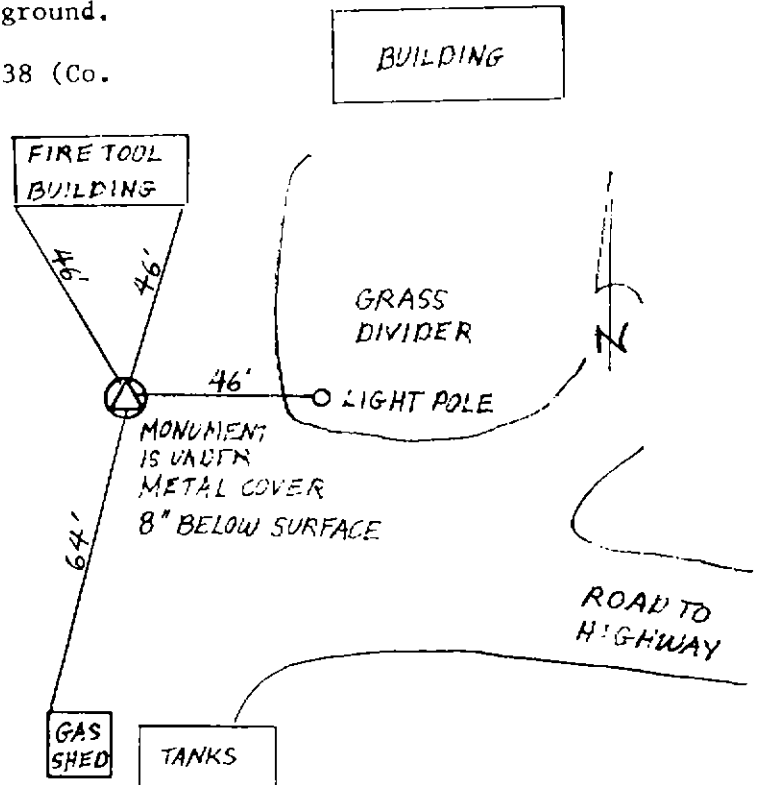

Reference Marks:

Note: For further information, contact the Douglas County Surveyor's Office, Room 205 Douglas County Justice Building, Roseburg, OR 97470. Phone 440-4278. Douglas County residents outside the Roseburg calling area, dial toll free 1-800-452-0991.