



OFFICE OF THE
DOUGLAS COUNTY SURVEYOR

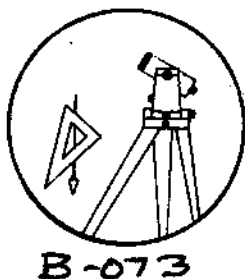

Station: BM LN. T 26 S, R 3W, Sec 10
Set By (Agency): Private-Gee
Date Set: 1980
Recovered By LEM
Date Recovered 5-80
Recovered By _____
Date Recovered _____
Recovered By _____
Date Recovered _____

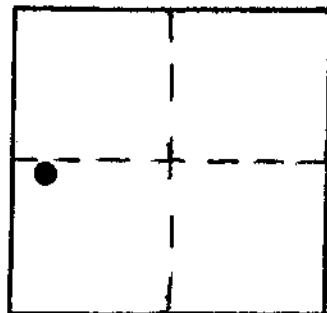

VERTICAL CONTROL N6VD 29

Elevation: 750.10 NGS Line # _____ USGS Line # _____ OSHD Line # _____
Precision: 3rd Agency: PLS #1191 Proj. # M 83-17 Date: 1980
Private-Gee

HORIZONTAL CONTROL


South Zone State Plane Coordinates: Y(Northing) _____ X(Easting) _____
Precision: _____ Agency: _____ Proj. # _____ Date: _____
Approximate Geographic Position: Latitude _____ Longitude _____

DESCRIPTION and TO REACH

Found: A standard DCSO disk stamped
"BM LN ELEV. 750.10 PLS 1191". Disk
is set in a 7" diam. concrete post
buried with 2 inches of monument a-
bove ground. Station is southerly of
Hwy. 138 centerline, 44.5 ft. with
witness sign and post set 4 ft. North.

To reach: From the Post Office at
Glide, proceed Easterly along Hwy #138
2.8 miles to driveway with suspended
foot bridge and monument on the right.

SKETCH

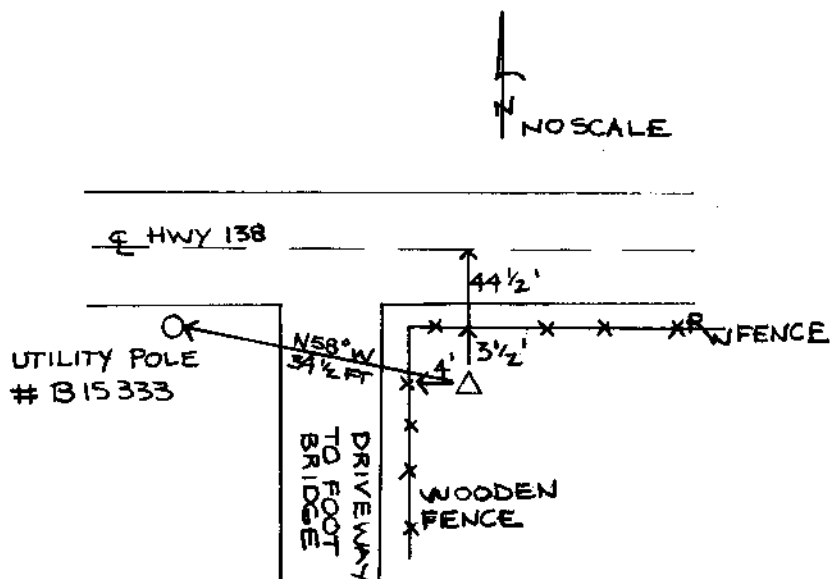

Reference Marks:

Note: For further information, contact the Douglas County Surveyor's Office, Room 205
Douglas County Justice Building, Roseburg, OR 97470. Phone 440-4278. Douglas
County residents outside the Roseburg calling area, dial toll free 1-800-452-0991.