



OFFICE OF THE
DOUGLAS COUNTY SURVEYOR

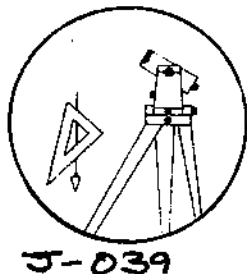

Station: J 476 T 26 S, R 3 W , Sec 11
Set By (Agency): USC&GS
Date Set: 1941
Recovered By RWS, SJF
Date Recovered 5/14/90
Recovered By _____
Date Recovered _____
Recovered By _____
Date Recovered _____

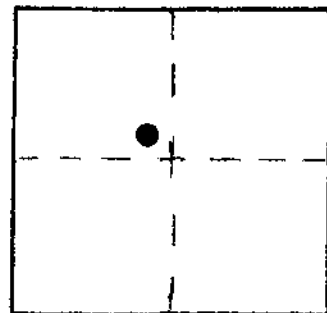

VERTICAL CONTROL NGVD 29

Elevation: 781.311 ft. NGS Line # 94 USGS Line # _____ OSHD Line # _____
Precision: 1st. order Agency: USC&GS Proj. # _____ Date: 1957

HORIZONTAL CONTROL


South Zone State Plane Coordinates: Y(Northing) N/A X(Easting) _____
Precision: _____ Agency: _____ Proj. # _____ Date: _____
Approximate Geographic Position: Latitude _____ Longitude _____

DESCRIPTION and TO REACH

SKETCH

A 3 1/2 inch diam. USC&GS disk stamped
"J 476 1941" set flush in top 18 inch
diam. concrete footing pad.

From the Idleyld Post Office
in T26S, R3W, Section 11 proceed westerly
along the North Umpqua Highway
(State Highway 138) 0.1 miles to the
monument on the left.

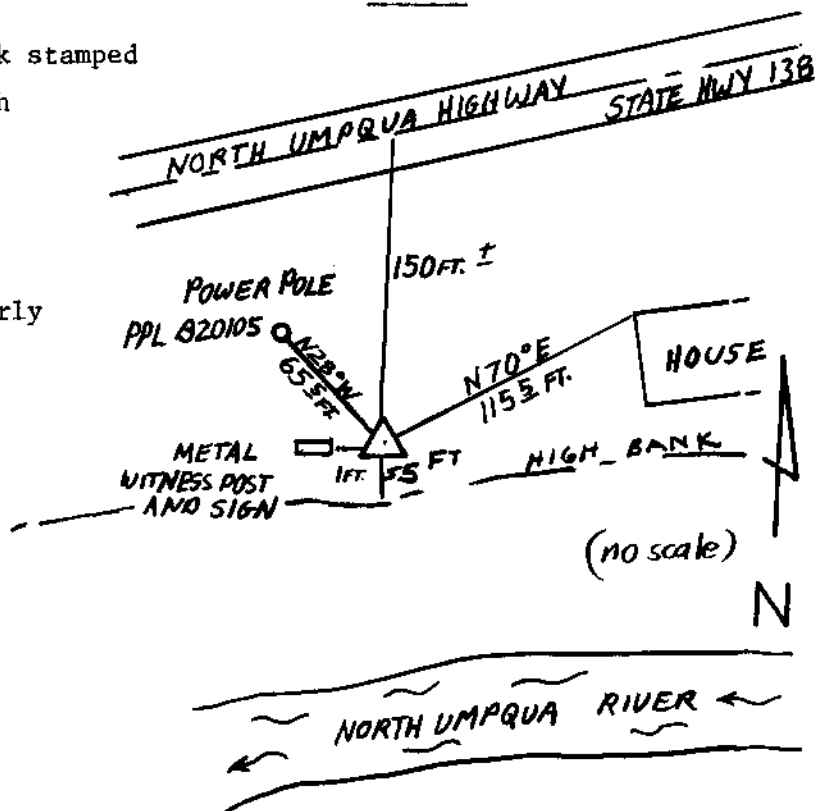

Reference Marks:

Note: For further information, contact the Douglas County Surveyor's Office, Room 205
Douglas County Justice Building, Roseburg, OR 97470. Phone 440-4278. Douglas
County residents outside the Roseburg calling area, dial toll free 1-800-452-0991.