



OFFICE OF THE
DOUGLAS COUNTY SURVEYOR

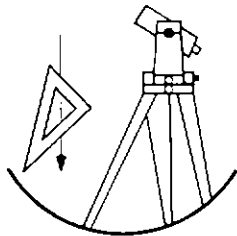

Station: A 749
Date Set: 1987
Set By (Agency): DCSO
DCSO Designation: A-081
Date Recovered: 8-93
Recovered By: S.JF RWS
Date Recovered: _____
Recovered By: _____
Date Recovered: _____
Recovered By: _____

T26W R5W Sec. 7

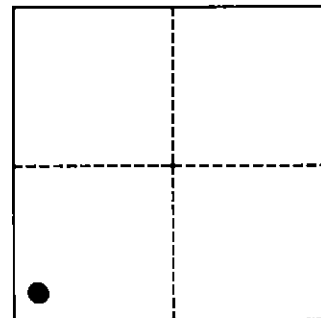

VERTICAL CONTROL


NGVD 29 Elevation: _____ FEET NAVD 88 Elevation: 141.260 METERS
NGS Line # L25035 USGS LINE # _____ OSHD Line # _____ FILE # _____
Precision: 1ST ORDER Agency: NGS Proj: _____ Date: 1988

HORIZONTAL CONTROL

O.C.S. 27 Y(Northing): _____ O.C.S. 83 Y(Northing): _____
(South Zone) X(Easting): _____ (South Zone) X(Easting): _____
Precision: _____ Agency: _____ Proj: _____ Date: _____
Approx. O.C.S. 27 Geographic Position: Latitude: 43°19'04" Longitude: 123°20'35"
Approx. O.C.S. 83 Geographic Position: Latitude: _____ Longitude: _____

Found: A 9/16 inch diameter stainless steel rod 6 - 5/8 inch aluminum collar and access cover set in concrete flush with ground. Collar stamped "A 749 1987".

To reach: Go to the intersection of State Hwy. 99 (Co. Rd. #388) and Wilbur Rd. (Co. Rd. #31) in T26S R5W Sec7 at Wilbur.

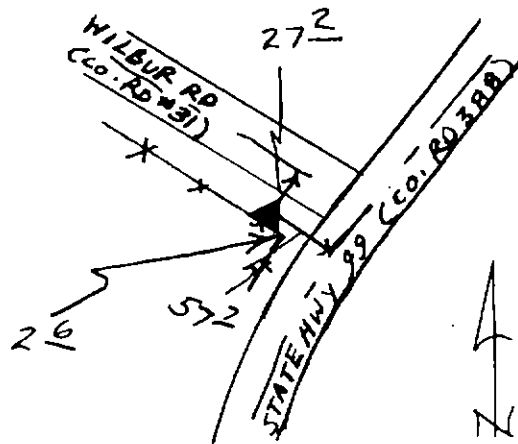

Note: For further information contact the Douglas County Surveyors Office, Room 205 Douglas County Justice Building, Roseburg, OR 97470. Phone 440-4272. Douglas County Residents outside Roseburg calling area, dial toll free 1-800-477-0991.