


OFFICE OF THE
DOUGLAS COUNTY SURVEYOR

Station: NU 11 T 26 S, R 5 W, Sec 21
 Set By (Agency): DCSO
 Date Set: 1972
 Recovered By RWS, SJF
 Date Recovered 9/16/85
 Recovered By _____
 Date Recovered _____
 Recovered By _____
 Date Recovered _____



n-039
NU 11

NAD 607358.53 4176564.69
83 43°17'57" 123°17'53"

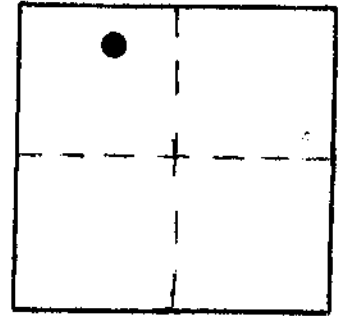

VERTICAL CONTROL NGVD 29

Elevation: 539.482 NGS Line # _____ USGS Line # _____ OSHD Line # _____
 Precision: 2nd Agency: DCSO Proj. # 2006 Date: 1973

HORIZONTAL CONTROL OCS 27

South Zone State Plane Coordinates: Y(Northing) 607,393.62 X(Easting) 1,255,605.66
 Precision: 1/25,000 Agency: DCSO Proj. # 2006 Date: 1973
 Approximate Geographic Position: Latitude 43°17'57" Longitude 123°17'49"


DESCRIPTION and TO REACH

SKETCH

A DCSO disk stamped "NU 11 1972" set in an 8 in. diam. concrete filled concrete belltile protruding 10 in. above ground.

TO REACH:

From the intersection of State Highway 99 and Page Rd. (Co. Rd. #115A) in T26S, R6W, Sec. 25, proceed easterly along Page Rd. approx. 3.9 miles to a point 100 ft. westerly of the end of County maintained Rd. Monument lies on left.

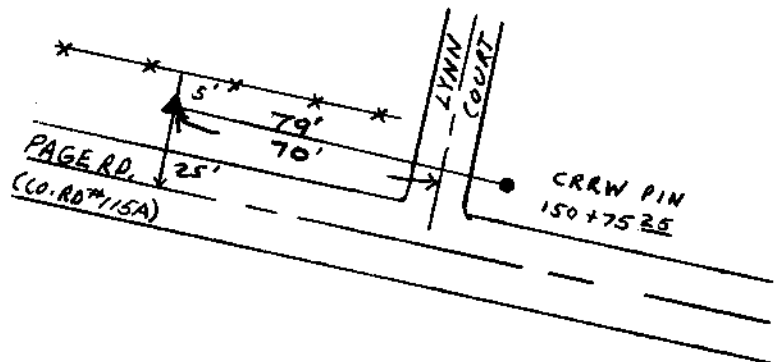

Reference Marks:

Note: For further information, contact the Douglas County Surveyor's Office, Room 205 Douglas County Justice Building, Roseburg, OR 97470. Phone 440-4278. Douglas County residents outside the Roseburg calling area, dial toll free 1-800-452-0991.