

Douglas County Geodetic Data Sheet


Station: NANCY

Designation: N-069

Date Set: 1999 Set By (Agency): DCSO

Last Date Recovered: 06/21/1999

T 26 R 05 WS 23

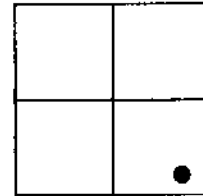

VERTICAL CONTROL

NGVD 29 Elevation: 641.39 Feet

Precision: 3RD ORDER Agency: DCSO

CS File: 66025

Date: 1999

NAVD 88 Elevation: Meters

Precision: Agency:

CS File:

Date:

HORIZONTAL CONTROL

OCS 27 Y(Northing): X(Easting):

Precision: GIS Agency:

Lat 43° 17' 17.4" Long: 123° 14' 52.9"

CS File: 66025 Date:

OCS 83 Y(Northing): X(Easting):

Precision: Agency:

Lat Long:

CS File: Date:

OCS 83/91 Y(Northing): X(Easting):

Precision: GIS Agency:

Lat 43° 17' 16.8" Long: 123° 14' 57.1"

CS File: 66025 Date:

OCS 83/98 Y(Northing): X(Easting):

Precision: Agency:

Lat Long:

CS File: Date:

Scaled Lat 43° 17' 17" Long: 123° 14' 53"


Description:

DCSO BRASS CAP STAMPED - NANCY 1999 - SET IN BED ROCK 3 FT. HIGHER THAN ROAD SURFACE

Comments:

FROM THE INTERSECTION OF NORTH BANK RD;
CO RD 200 AND ECHO BEND ROAD; CO RD 363 IN
T26S R5W SEC 23; PROCEED EASTERLY ALONG
NORTH BANK RD 0.3 MILES TO MONUMENT ON
LEFT

Notes:

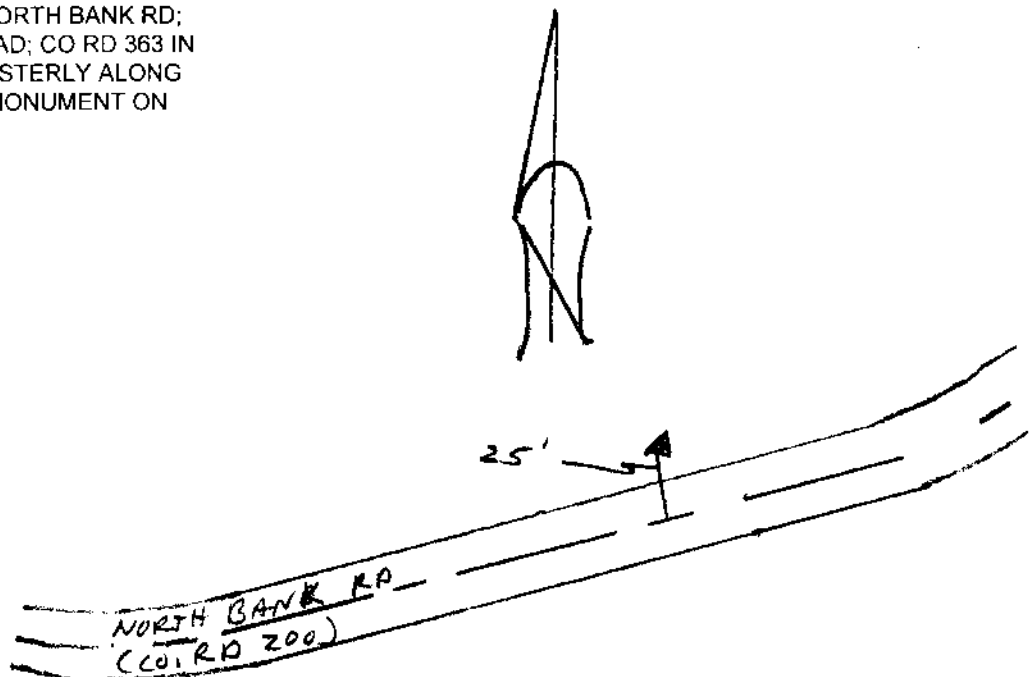

Note: For further information contact the Douglas County Surveyors Office, Room 105A Douglas County Courthouse, Roseburg, OR 97470. Phone 440-4272 or Fax (541)957-8150. Douglas County Residents outside Roseburg calling area, dial toll free 1-800-224-1619.