


OFFICE OF THE
DOUGLAS COUNTY SURVEYOR

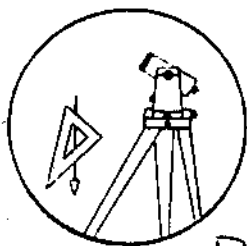

P-118

Station: PAGE-1

T 26 S, R 5W, Sec 30


Date Set: 2000

Set By (Agency): DCSO

Date Recovered: 3-23-00

Recovered By: RWS SJF

- | | |
|-------------------------------------|---|
| ☐ Found | ☒ New |
| ☐ Reset | ☐ Not Found |
| ☐ Referenced | ☐ Destroyed |

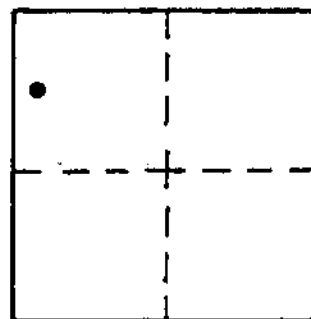

VERTICAL CONTROL NGVD 29

Elevation: 511.08 NGS Line # _____ USGS Line # _____ OSHD Line # _____

Precision: 3rd Agency: DCSO Proj. # 2007 Date: 2000

HORIZONTAL CONTROL

South Zone O.C.S. 27: Y(Northing) _____ X(Easting) _____

South Zone O.C.S. 83: Y(Northing) _____ X(Easting) _____

Precision: _____ Agency: _____ Proj. # _____ Date: _____

Approx. NAD ⁸³ Geographic Position: Latitude 43° 17' 00.3" Longitude 123° 20' 47.8"
₂₁ (27) 43° 17' 00.9" 123° 20' 43.6"

DESCRIPTION and TO REACH

DCSO DRILL CAP SET IN CONCRETE CURB
STAMPED "PAGE-1 2000"

GO TO THE INTERSECTION OF THORA CIRCLE RD
(CO. RD # 335E) AND PAGE RD (CO. RD # 115A)
IN T26S R5W SEC. 30. MONUMENT IS NORTH
OF INTERSECTION

Reference Marks:

