


OFFICE OF THE
DOUGLAS COUNTY SURVEYOR

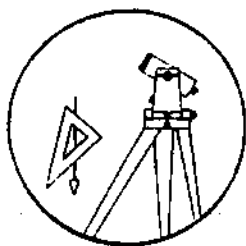

P-120

Station: PAGE - 3

T 26 S, R 5W, Sec 30


Date Set: 2000

Set By (Agency): DCSO

Date Recovered: 3-23-00

Recovered By: RWS SIF

☐ Found ☒ New
☐ Reset ☐ Not Found
☐ Referenced ☐ Destroyed

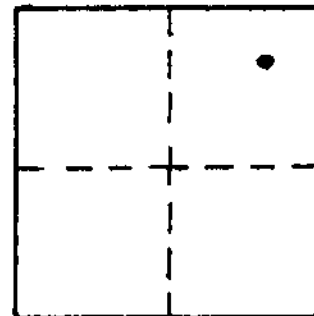

VERTICAL CONTROL NGVD 29

Elevation: 481.36 NGS Line # _____ USGS Line # _____ OSHD Line # _____

Precision: 3rd Agency: DCSO Proj. # 2007 Date: 2000

HORIZONTAL CONTROL

South Zone O.C.S. 27: Y(Northing) _____ X(Easting) _____

South Zone O.C.S. 83: Y(Northing) _____ X(Easting) _____

Precision: _____ Agency: _____ Proj. # _____ Date: _____

Approx. NAD ~~83~~ ²¹ Geographic Position: Latitude 43° 17' 02.3" Longitude 123° 19' 48.8"
(21) 43° 17' 02.3" 123° 19' 44.5"

DESCRIPTION and TO REACH

DCSO DRILL CAP SET IN ROCK OUTCROP STAMPED
"PAGE-3 2000" APPROX. 2 FT ABOVE PAVEMENT

FROM THE INTERSECTION OF PAGE RD (CO. RD # 115A)
AND STATE HWY 99 INT T26S R6W SEC 25
PROCEED NORTH EASTERLY ALONG PAGE RD
1.35 MILE TO MONUMENT ON RIGHT

Reference Marks:

