

OFFICE OF THE
DOUGLAS COUNTY SURVEYOR

Station: U-3 Reset T 26 S, R 6W, Sec 20

Set By (Agency): DCSO

Date Set: 1974

Recovered By GQ - JP


Date Recovered 1-7-82; ok 11/4/98

Recovered By _____

Date Recovered _____

Recovered By _____

Date Recovered _____

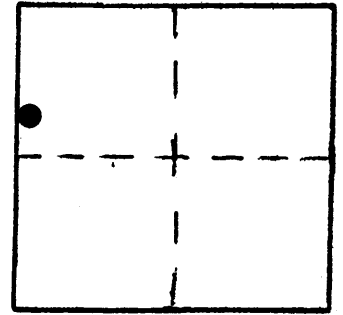

U-003
U-3 RESET

26S 6W 20

NAD 607566.68 4137083.28
83 43°17'45" 123°26'47"

VERTICAL CONTROL NGVD 29

Elevation: 397.625 NGS Line # _____ USGS Line # _____ OSHD Line # _____

Precision: 2nd Agency: DCSO Proj. # 2007 Date: 1991

HORIZONTAL CONTROL OCS 27

South Zone State Plane Coordinates: Y(Northing) 607,601.66 X(Easting) 1,216,124.62

Precision: 1/25,000 Agency: DCSO Proj. # 2006 Date: 1974


Approximate Geographic Position: Latitude 43°17'47" Longitude 123°26'43"

DESCRIPTION and TO REACH

SKETCH

Found: A standard DCSO disk set in concrete tile protruding 2" out of the ground and is marked "U-3 Reset 1974".

To reach: From Roseburg proceed Northwesterly along Co. Rd. #6 to approx. 8.5 mile point and the intersection of Co. Rd. #6 & Co. Rd. #208 (Upper Cleveland Rapids Rd.) Station is just North of intersection.

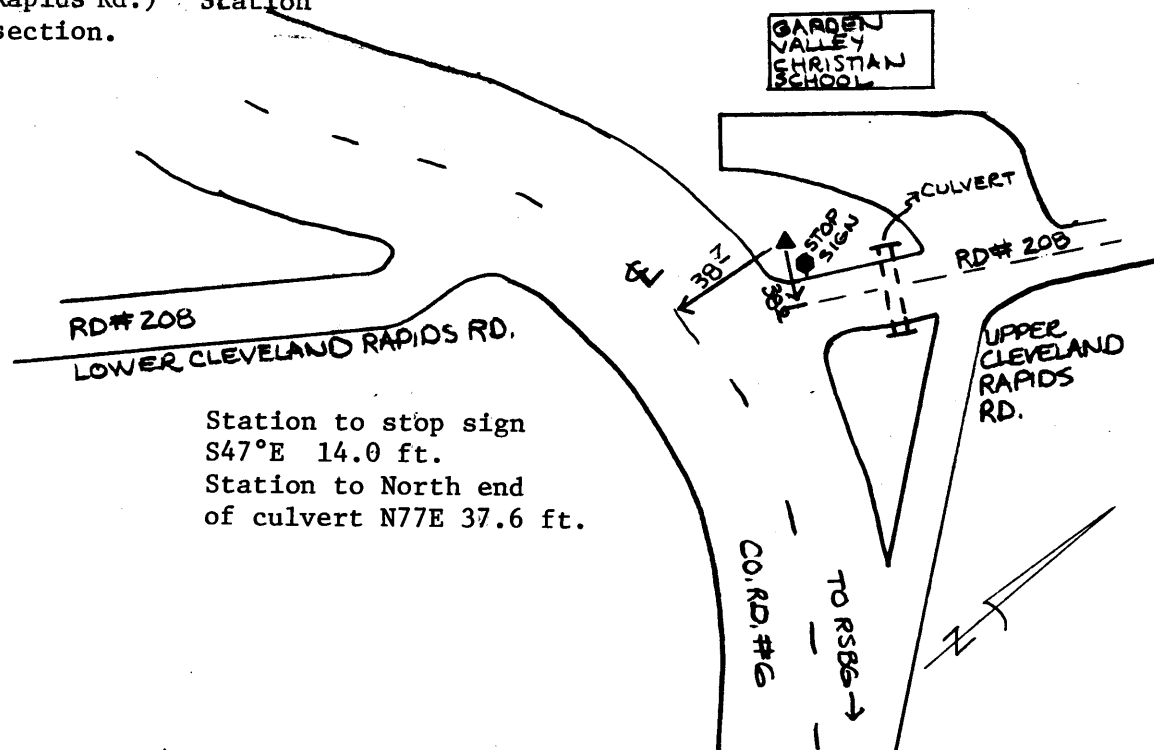

Reference Marks:

Station to stop sign
S47°E 14.0 ft.
Station to North end
of culvert N77°E 37.6 ft.

Note: For further information, contact the Douglas County Surveyor's Office, Room 205 Douglas County Justice Building, Roseburg, OR 97470. Phone 440-4278. Douglas County residents outside the Roseburg calling area, dial toll free 1-800-452-0991.