

Douglas County Geodetic Data Sheet


T 26 R 06 WS 23

Station: CART

Designation: C-157

Date Set: 1998 Set By (Agency): DCSO

Last Date Recovered: 08/31/1998

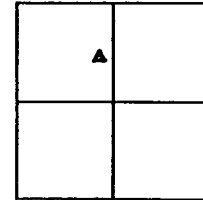

VERTICAL CONTROL

NGVD 29 Elevation: 430.36 Feet

Precision: 3RD ORDER Agency: DCSO

CS File: 66027

Date: 1998

NAVD 88 Elevation: 433.84 FT.

Precision: CORPSCON⁶ Agency:
NAVD88

CS File:

Date:

HORIZONTAL CONTROL

OCS 27 Y(Northing): *607904* X(Easting):

Lat

Long:

Precision: Agency:

CS File:

Date:

OCS 83 Y(Northing): *607904* X(Easting): *4155503* Lat

Long:

Precision: *GIS SCALED* Agency: *DCSO*

CS File:

Date: *2014*

OCS 83/91 Y(Northing): X(Easting):

Lat

Long:

Precision: Agency:

CS File:

Date:

OCS 83/98 Y(Northing): X(Easting):

Lat

Long:

Precision: Agency:

CS File:

Date:

Scaled Lat 43° 17' 55"


Long: 123° 22' 33"

Description:

A DCSO BRASS CAP STAMPED; CART 1998; SET FLUSH IN TOP OF 6 1/2 INCH WIDE CONCRETE CURBING ON NORTHERLY EDGE OF SEMI-CIRCULAR DRIVEWAY. CONCRETE PROTRUDES APPROX. 5 INCHES ABOVE THE GROUND.

Comments:

FROM THE INTERSECTION OF FISHER RD; CO. RD 189; AND EASTERLY END OF RIVER BEND ROAD; CO. RD 224; IN T26S R6W SEC.23; PROCEED NORTHWESTERLY ALONG RIVER BEND ROAD APPROX. 0.3 MILES TO MONUMENT ON LEFT.

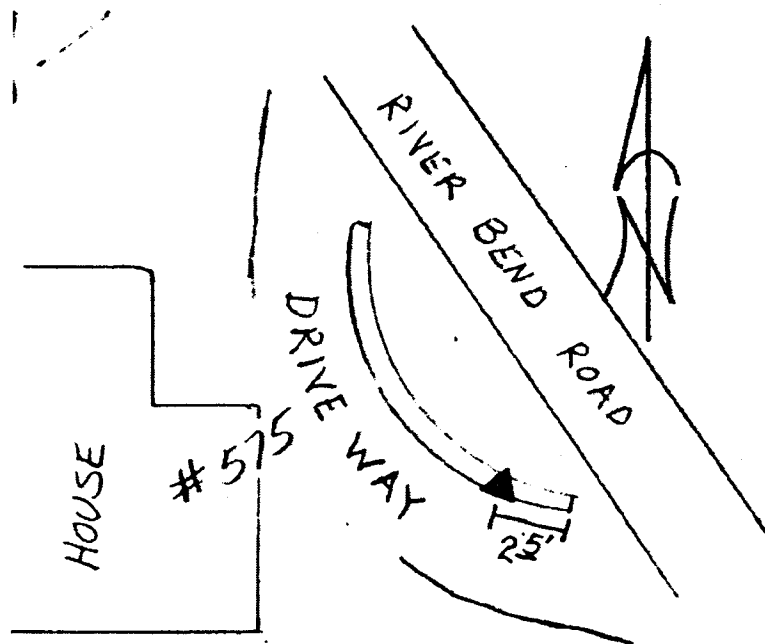

Notes:

Note: For further information contact the Douglas County Surveyors Office, Room 105A Douglas County Courthouse, Roseburg, OR 97470. Phone 440-4272 or Fax (541)957-8150. Douglas County Residents outside Roseburg calling area, dial toll free 1-800-224-1619.