


Douglas County Geodetic Data Sheet

T 26 R 06 WS 27

Station: DILBECK
 Date Set: 1998 Set By (Agency): DCSO
 Last Date Recovered: 09/02/1998

Designation: D-085

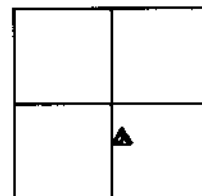

VERTICAL CONTROL

NGVD 29 Elevation: 413.40 Feet
 Precision: 3RD ORDER Agency: DCSO

CS File: 66027

Date: 1998

NAVD 88 Elevation: Meters
 Precision: Agency:

CS File:

Date:

HORIZONTAL CONTROL

OCS 27	Y(Northing):	X(Easting):	Lat	Long:
Precision:	Agency:		CS File:	Date:
OCS 83	Y(Northing):	X(Easting):	Lat	Long:
Precision:	Agency:		CS File:	Date:
OCS 83/91	Y(Northing):	X(Easting):	Lat	Long:
Precision:	Agency:		CS File:	Date:
OCS 83/98	Y(Northing):	X(Easting):	Lat	Long:
Precision:	Agency:		CS File:	Date:


Scaled Lat 43° 16' 35" Long: 123° 23' 36"

Description:

A 2 INCH DIA. BRASS CAP STAMPED; DILBECK 1998; SET IN TOP OF CONCRETE STORM DRAIN GRATE

Comments:

FROM THE INTERSECTION OF GARDEN VALLEY ROAD; CO.RD 6; AND FISHER ROAD; CO. RD 189; IN T26S R6W SEC. 34; PROCEED NORTHEASTERLY ALONG FISHER ROAD 1.1 MILES TO MONUMENT ON LEFT.

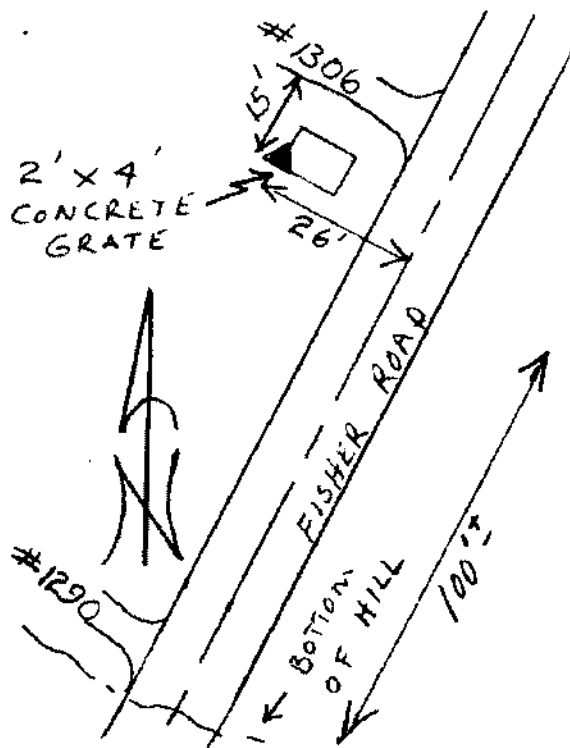

Notes:

Note: For further information contact the Douglas County Surveyors Office, Room 105A Douglas County Courthouse, Roseburg, OR 97470. Phone 440-4272 or Fax (541)957-8150. Douglas County Residents outside Roseburg calling area, dial toll free 1-800-224-1619.