


2/82

OFFICE OF THE

u-133
UW-12

26S 7W 2

DOUGLAS COUNTY SURVEYOR

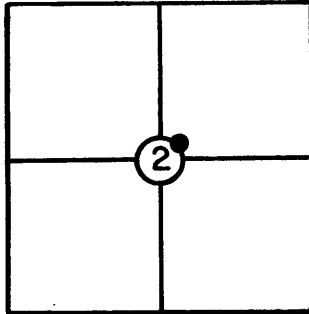NAD 623878.71 4124328.77
83 43°20'22" 123°29'47"T 26 S, R 7W, Sec. 2Station: UW-12Set By (Agency): DCSODate: 1974VERTICAL CONTROL


NGVD29

Elevation: 472.578 NGS(USC&GS) Line # _____ USGS Line # _____Order _____ (River Floodplain)
Of Precision 2nd Agency: DCSO Proj. #: 2006 Date: 1974HORIZONTAL CONTROL

OCS 27

Oregon State Plane Coordinates: Y(Northing) 623,913.73 X(Easting) 1,203,369.48
(South Zone)Order _____ (River Floodplain)
Of Precision 1/25,000 Agency: DCSO Proj. #: 2006 Date: 1974Approximate Geographic Position: Latitude= 43° 20' 22" Longitude= 123° 29' 43"DESCRIPTION: Station is brass cap cementedinto a belltile 3ft. E. of witness sign.Cap stamped "UW-12 1974". To reach fromMelrose Store proceed N'thly on Co. Rd. #138.43 mi. to Joelson Rd. intersection &station on left.VICINITY: Joelson Rd. Intersection withUmpqua Melrose Rd. (Co. Rd. #13).

SKETCH

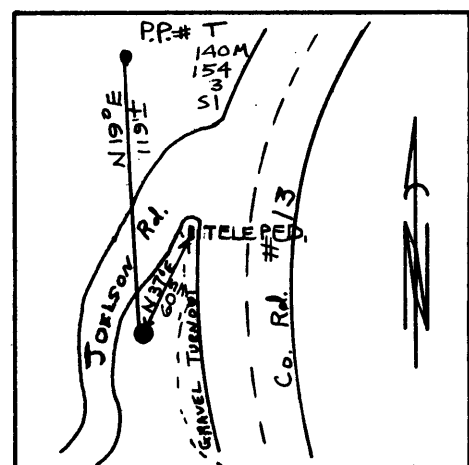

NOTE: For Possible Further Information On This Station, Please Contact The Douglas County Surveyors Office, Rm. 205 Douglas County Justice Bldg., Roseburg, OR. 97470 Phone 672-3311 Ext. 272.. Douglas County residents outside the Roseburg calling area dial toll free 1-800-452-0991.