



OFFICE OF THE
DOUGLAS COUNTY SURVEYOR

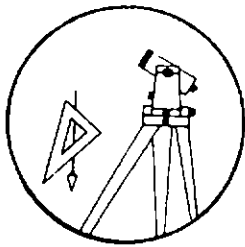

Station: L 480 T 27 S, R 5 E, Sec 3 ^{UNS}
Set By (Agency): USC & GS
Date Set: 1941
Recovered By FLI (DCSO)
Date Recovered 7-23-84
Recovered By Harry Heislein (USFS)
Date Recovered Fall 1985
Recovered By _____
Date Recovered _____

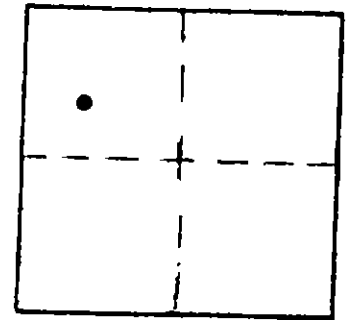

VERTICAL CONTROL

Elevation: 4267.544 (DISTURBED) NGS Line # 94 USGS Line # _____ OSHD Line # _____
Precision: 1st Agency: USC & GS Proj. # _____ Date: 1961

HORIZONTAL CONTROL

South Zone State Plane Coordinates: Y(Northing) _____ X(Easting) _____
Precision: _____ Agency: _____ Proj. # _____ Date: _____
Approximate Geographic Position: Latitude _____ Longitude _____

DESCRIPTION and TO REACH

0.5 miles SW along U.S.F.S. Road
No. 4785 from intersection with
Highway 138.

SKETCH

Brass cap in concrete post, 25
feet SE of centerline of Road.

Shown on USGS Quads: Summit Lake 15' Quad.
Lemolo Lake 7 1/2' Quad.

Reference Marks:

Note: For further information, contact the Douglas County Surveyor's Office, Room 205
Douglas County Justice Building, Roseburg, OR 97470. Phone 440-4278. Douglas
County residents outside the Roseburg calling area, dial toll free 1-800-452-0991.