

OFFICE OF THE
DOUGLAS COUNTY SURVEYOR

Station: M-496 RESET

T 25 S, R 7 W , Sec 26

Date Set: 1992

Set By (Agency): DCSO

Date Recovered: 3/18/92


Recovered By: RWS, SJF

Date Recovered: _____

Recovered By: _____

Date Recovered: _____

Recovered By: _____

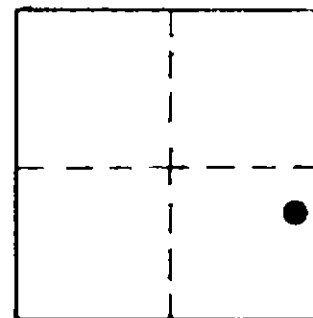

M-091 25S 7W 26
M-496 RESET

NAD 633194.24 4126975.08
83 43°21'55" 123°29'16"

VERTICAL CONTROL

Elevation: 364.933 NGS Line # _____ USGS Line # _____ OSHD Line # _____

Precision: 2nd Agency: DCSO Proj. # 2013 Date: 1992

HORIZONTAL CONTROL

South Zone O.C.S. 27: Y(Northing) 633,229.12 X(Easting) 1,206,015.90

South Zone O.C.S. 83: Y(Northing) _____ X(Easting) _____

Precision: 1/25,000 Agency: DCSO Proj. # 2013 Date: 1992


Approx. NAD 83 Geographic Position: Latitude 43°21'55" Longitude 123°29'11"

DESCRIPTION and TO REACH

SKETCH

A DCSO disk stamped "M-496 RESET 1992" set in a 6" dia. by 42" long concrete filled belltile, protruding 6" above ground.

Go to the intersection of Hubbard Creek Rd. (Co. Rd. #6) and Melqua Rd. (Co. Rd. #13A) in T25S,R7W,Sec.26, monument is on southeast side of intersection.

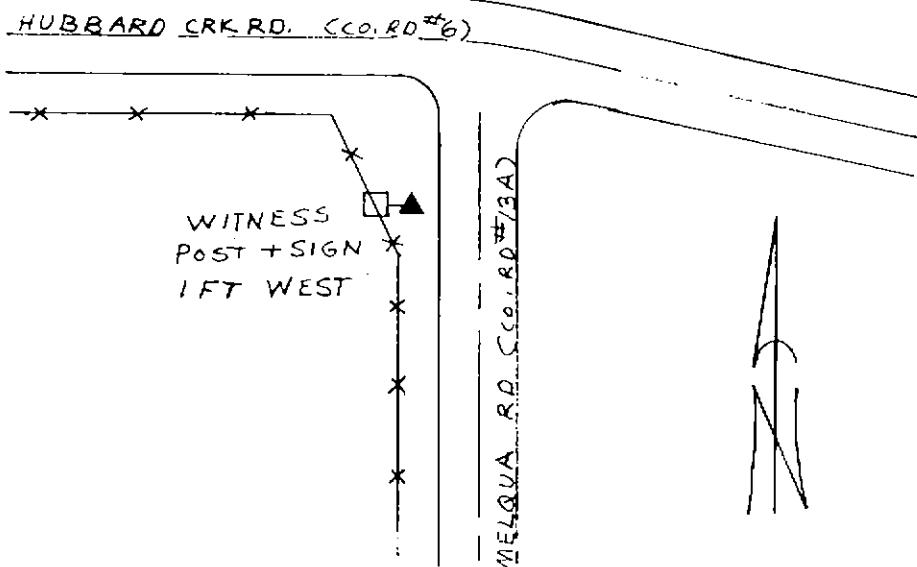

Reference Marks:

Note: For further information, contact the Douglas County Surveyor's Office, Room 205 Douglas County Justice Building, Roseburg, OR 97470. Phone 440-4278. Douglas County residents outside the Roseburg calling area, dial toll free 1-800-452-0991.



3. 7. 2000