



OFFICE OF THE
DOUGLAS COUNTY SURVEYOR

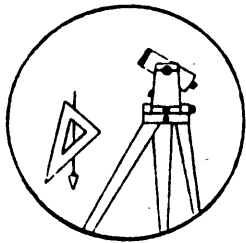

Station: STILL
Date Set: 2000
Set By (Agency): DCSO
Date Recovered: 3-30-00
Recovered By: RUS SJF

T 22 S, R 6W, Sec 15

☐ Found ☒ New
☐ Reset ☐ Not Found
☐ Referenced ☐ Destroyed

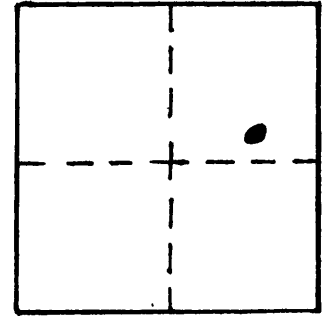

S-193

VERTICAL CONTROL NGVD 29

Elevation: 442.96 NGS Line # _____ USGS Line # _____ OSHD Line # _____
Precision: 3rd Agency: DCSO Proj. # 66/38 Date: 2000

HORIZONTAL CONTROL

South Zone O.C.S. 27: Y(Northing) _____ X(Easting) _____

South Zone O.C.S. 83: Y(Northing) _____ X(Easting) _____

Precision: _____ Agency: _____ Proj. # _____ Date: _____

Approx. NAD 83 Geographic Position: Latitude 43° 13' 21.7" Longitude 123° 23' 22.7"
(27) 43° 13' 22.3" 123° 23' 18.5"

DESCRIPTION and TO REACH

DCSO DRILL CAP STAMPED "STILL 2000" SET
IN CONCRETE CURB

GO TO THE INTERSECTION OF CEDAR RIDGE CT
AND TROST ST IN ROSEBURG MONUMENT LB
AT NORTH WEST CORNER OF INTERSECTION.

Reference Marks:

