


OFFICE OF THE
DOUGLAS COUNTY SURVEYOR

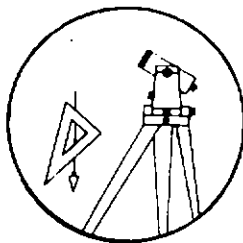

Station: T-480 T 27 S, R 6 E, Sec 17 ^{UNS}

Set By (Agency): USC & GS

Date Set: 1941

Recovered By FLI (DCSO)


Date Recovered 6-15-84

Recovered By _____

Date Recovered _____

Recovered By _____

Date Recovered _____

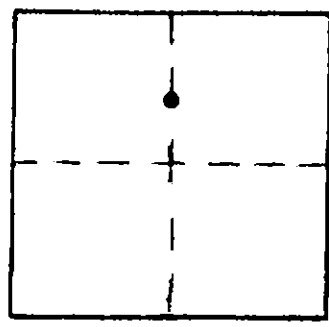

VERTICAL CONTROL

Elevation: 5017.064 NGS Line # 94 USGS Line # _____ OSHD Line # _____

Precision: 2nd Agency: DCSO Proj. # 2004-8 CS57/23 Date: 1974

HORIZONTAL CONTROL

South Zone State Plane Coordinates: Y(Northing) _____ X(Easting) _____

Precision: _____ Agency: _____ Proj. # _____ Date: _____


Approximate Geographic Position: Latitude _____ Longitude _____

DESCRIPTION and TO REACH

SKETCH

1.0 mi. south of Cinnamon
Butte Road.

B.C. set in 6 ft. diameter
boulder 2 ft. above ground.

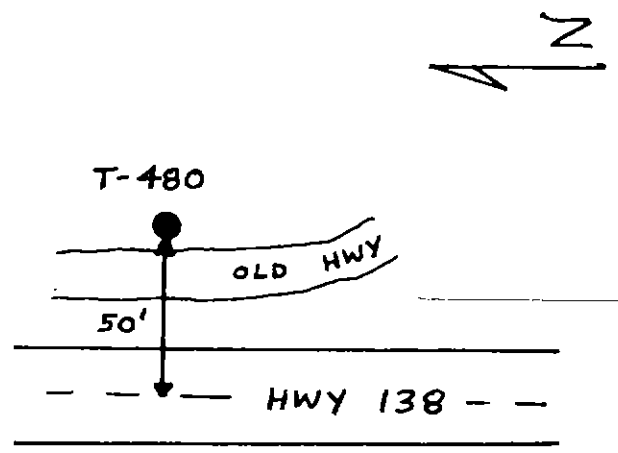

Reference Marks:

Note: For further information, contact the Douglas County Surveyor's Office, Room 205 Douglas County Justice Building, Roseburg, OR 97470. Phone 440-4278. Douglas County residents outside the Roseburg calling area, dial toll free 1-800-452-0991.