



OFFICE OF THE  
DOUGLAS COUNTY SURVEYOR

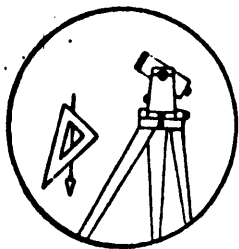

T-031

Station: THERESA T 27 S, R 6 W, Sec 24  
 Set By (Agency): BALL (LS 1123)  
 Date Set: 1980  
 Recovered By JP, RS  
 Date Recovered 8/29/83  
 Recovered By RWS-SJF  
 Date Recovered 2000  
 Recovered By \_\_\_\_\_  
 Date Recovered \_\_\_\_\_

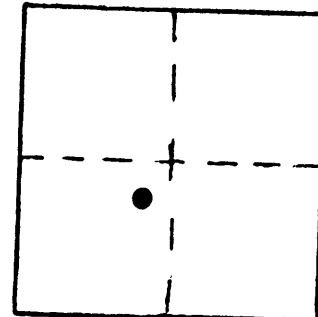

VERTICAL CONTROL NGVD 29

Elevation: 452.22 NGS Line # \_\_\_\_\_ USGS Line # \_\_\_\_\_ OSHD Line # \_\_\_\_\_  
 Precision: 3rd Agency: LS 1123 Proj. # MLP M85-61 Date: 1980

HORIZONTAL CONTROL

South Zone State Plane Coordinates: Y(Northing) \_\_\_\_\_ X(Easting) \_\_\_\_\_  
 Precision: \_\_\_\_\_ Agency: \_\_\_\_\_ Proj. # \_\_\_\_\_ Date: \_\_\_\_\_

OCS27 Approximate Geographic Position: Latitude 43° 12' 13.0" Longitude 123° 21' 25.8"


DESCRIPTION and TO REACH NAD (83) 43° 12' 12.4" SKETCH 123° 21' 30.1"

DESCRIPTION:

A disk stamped "THERESA LS 1123 452.22 1980" set flush in concrete post.

TO REACH:

From intersection of SW Portland Ave. and SW Kendall St. in T27S, R6W, Sec. 25 proceed northerly along SW Kendall St. 0.35 miles to City (RSBG) bike path (parking area) and monument on left.

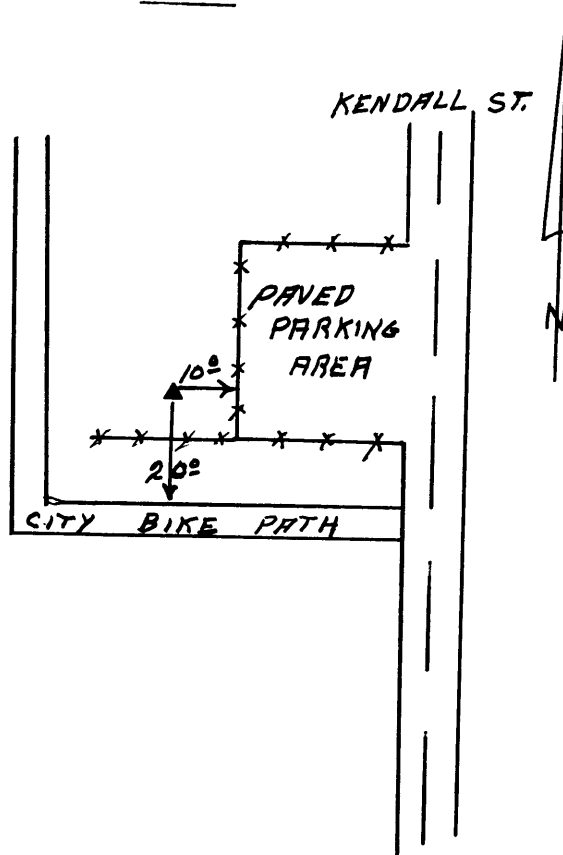

Reference Marks:

Note: For further information, contact the Douglas County Surveyor's Office, Room 205 Douglas County Justice Building, Roseburg, OR 97470. Phone 440-4278. Douglas County residents outside the Roseburg calling area, dial toll free 1-800-452-0991.