


write/rain

OFFICE OF THE
DOUGLAS COUNTY SURVEYOR

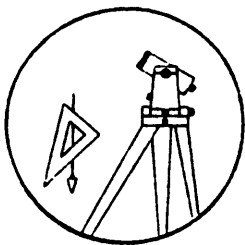

K-048

Station: KEN

T 27 S, R 6, Sec 25


Date Set: 2000

Set By (Agency): DCSO

Date Recovered: 5-4-00

Recovered By: RWS, SJF

- | | |
|-------------------------------------|---|
| ☐ Found | ☒ New |
| ☐ Reset | ☐ Not Found |
| ☐ Referenced | ☐ Destroyed |

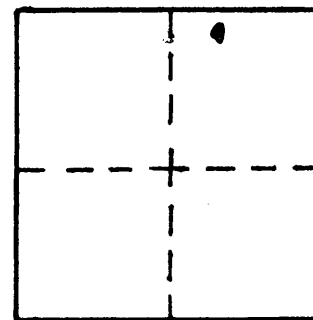

VERTICAL CONTROL NGVD 29

Elevation: 462.76 NGS Line # _____ USGS Line # _____ OSHD Line # _____

Precision: 3rd Agency: DCSO Proj. # CS 66/38 Date: 2000

HORIZONTAL CONTROL

South Zone O.C.S. 27: Y(Northing) _____ X(Easting) _____

South Zone O.C.S. 83: Y(Northing) _____ X(Easting) _____

Precision: _____ Agency: _____ Proj. # _____ Date: _____

Approx. NAD ~~83~~ ⁸³ Geographic Position: Latitude 43° 11' 56.8" Longitude 123° 21' 09.8"
(83) 43° 11' 56.2" 123° 21' 14.0"

DESCRIPTION and TO REACH

DCSO DRILL CAP SET IN OLD CONCRETE
RAILROAD SEMAPHORE. STAMPED "KEN 2000"

GO TO THE SOUTH END OF MILL STREET
MONUMENT IS ALONG EAST SIDE OF TRACKS
NEAR NEW SEMAPHORE STATION 5717 AND 5716

Reference Marks:

