

OFFICE OF THE
DOUGLAS COUNTY SURVEYOR

Station: NEWFAIR


T 27 S, R 6W, Sec 25

Date Set: 2000

Set By (Agency): DCSO


Date Recovered: 5/23/2000

Recovered By: SJF

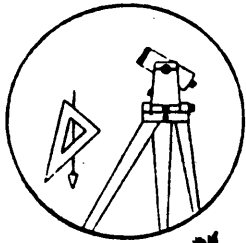

N-072

- Found
- New
- Reset
- Not Found
- Referenced
- Destroyed

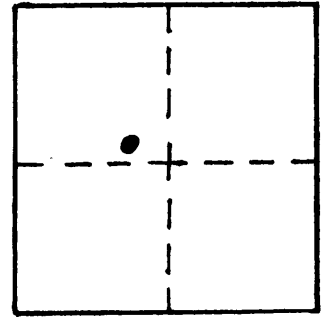

VERTICAL CONTROL NGVD 29

Elevation: 462.95 NGS Line # _____ USGS Line # _____ OSHD Line # _____

Precision: 3rd Agency: DCSO Proj. # 66/38 Date: 2000

HORIZONTAL CONTROL

South Zone O.C.S. 27: Y(Northing) _____ X(Easting) _____

South Zone O.C.S. 83: Y(Northing) _____ X(Easting) _____

Precision: _____ Agency: _____ Proj. # _____ Date: _____

Approx. NAD ⁸³/₂₇ Geographic Position: Latitude 43° 11' 41" Longitude 123° 21' 29"

DESCRIPTION and TO REACH

A DCSO DRILL CAP STAMPED "NEWFAIR 2000"
SET FLUSH IN CONCRETE CURBING AT SOUTHERLY END
OF CONCRETE SIDEWALK

GO TO THE MAIN DOUGLAS COUNTY FAIRGROUNDS
ENTRANCE ON FREAR ST. IN T27S, R6W, SEC. 25.
MONUMENT LIES ON EAST SIDE OF FREAR ST. AND
APPROXIMATELY 280' SOUTH FROM FAIRGROUNDS ENTRANCE.

Reference Marks:

