



OFFICE OF THE
DOUGLAS COUNTY SURVEYOR

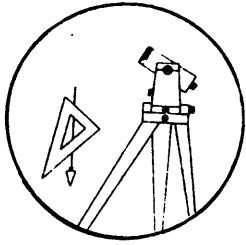

P.100

Station: PIT T 27 S, R 6 W, Sec 29
Set By (Agency): DCSO
Date Set: 1989
Recovered By RWS, SJF
Date Recovered 6/1/89
Recovered By _____
Date Recovered _____
Recovered By _____
Date Recovered _____

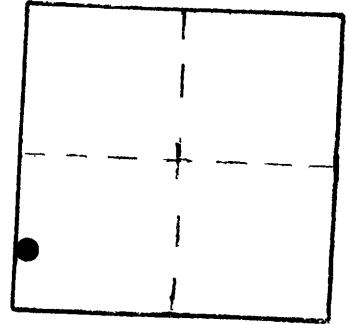

VERTICAL CONTROL NGVD 29

Elevation: 859.397 NGS Line # _____ USGS Line # _____ OSHD Line # _____
Precision: 2nd Agency: DCSO Proj. # 2007 Date: 1990

HORIZONTAL CONTROL



South Zone State Plane Coordinates: Y(Northing) _____ X(Easting) _____
Precision: _____ Agency: _____ Proj. # _____ Date: _____
Approximate Geographic Position: Latitude _____ Longitude _____

DESCRIPTION and TO REACH

SKETCH

A DCSO disk stamped "PIT 1989" set in an 8 in. dia. by 42 in. long concrete filled belltile flush with ground.

From the intersection of Lookingglass Rd. (Co.Rd.#5D) and Nandy Rd. (Co.Rd.#336) in T27S,R7W,Sec.25, proceed northeasterly along Lookingglass Rd. 1.35 miles to monument on right.

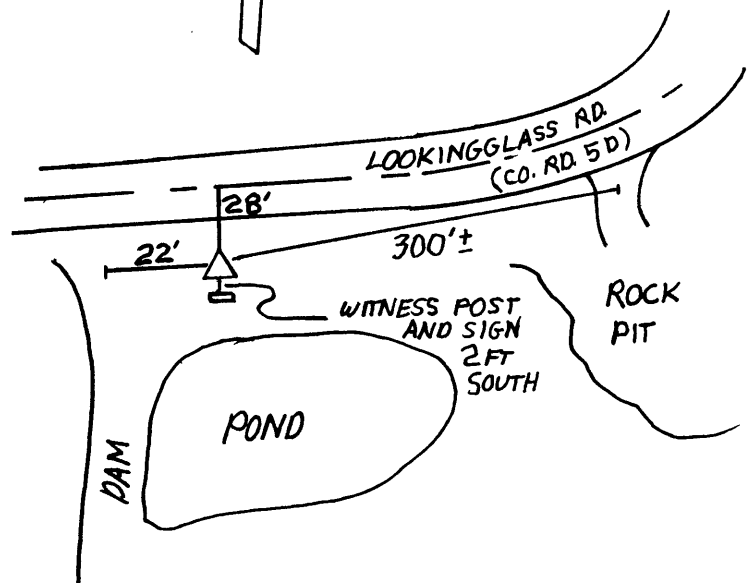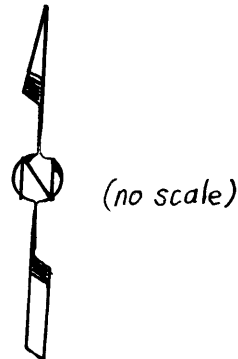

Reference Marks:

Note: For further information, contact the Douglas County Surveyor's Office, Room 205 Douglas County Justice Building, Roseburg, OR 97470. Phone 440-4278. Douglas County residents outside the Roseburg calling area, dial toll free 1-800-452-0991.