



OFFICE OF THE
DOUGLAS COUNTY SURVEYOR

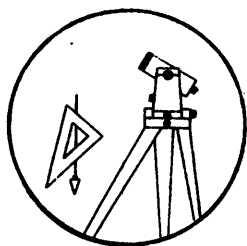

Y-016

Station: Y 596 T 27 S, R 6 W., Sec 35
Set By (Agency): OSHD
Date Set: 1965
Recovered By RWS, SJF
Date Recovered 2/26/85
Recovered By _____
Date Recovered _____
Recovered By _____
Date Recovered _____

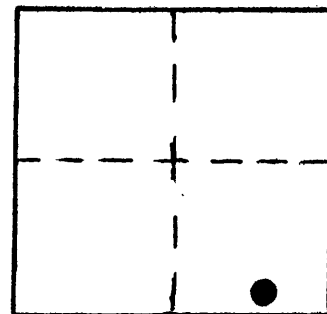

VERTICAL CONTROL NGVD 29

Elevation: 512.30 NGS Line # _____ USGS Line # _____ OSHD Line # 369
Precision: 3rd Agency: OSHD Proj. # _____ Date: 1977

HORIZONTAL CONTROL


South Zone State Plane Coordinates: Y(Northing) _____ X(Easting) _____
Precision: _____ Agency: _____ Proj. # _____ Date: _____
Approximate Geographic Position: Latitude _____ Longitude _____

DESCRIPTION and TO REACH

SKETCH

An OSHD disk stamped "Y 596 1965"
set flush in the Northeast corner
of a farm equipment overcrossing.

From the Winston-Green on-ramp to
I-5 north in T. 28 S., R. 6 W.,
Sec. 2, proceed northerly along I-5
approximately 1.0 miles to monument
on right.

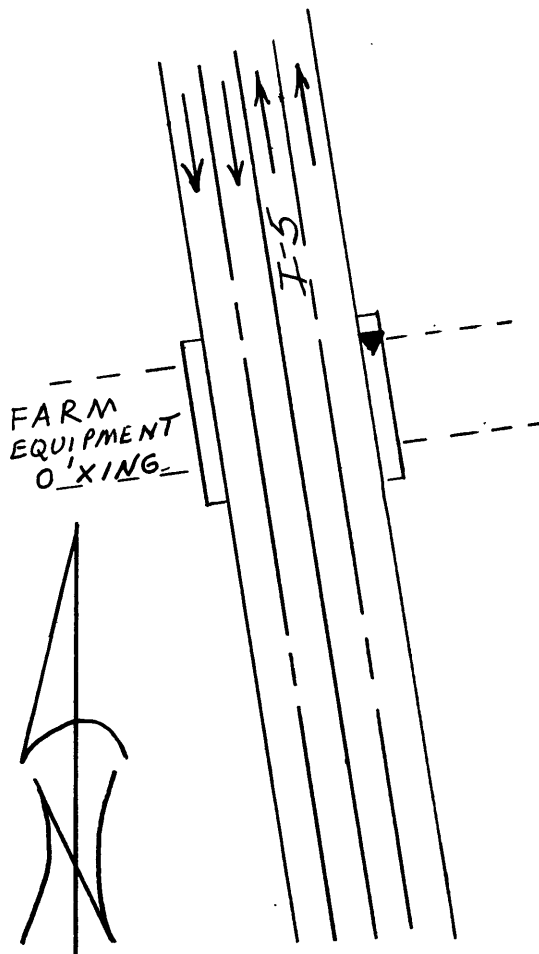

Reference Marks:

Note: For further information, contact the Douglas County Surveyor's Office, Room 205
Douglas County Justice Building, Roseburg, OR 97470. Phone 440-4278. Douglas
County residents outside the Roseburg calling area, dial toll free 1-800-452-0991.