



OFFICE OF THE
DOUGLAS COUNTY SURVEYOR

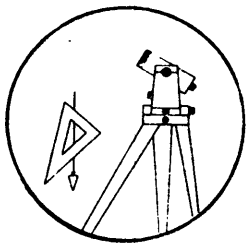

S-167

Station: SIVIK T 27 S, R 7 W, Sec 13
Set By (Agency): DCSO
Date Set: 1989
Recovered By RWS, SJF
Date Recovered 5/30/89
Recovered By _____
Date Recovered _____
Recovered By _____
Date Recovered _____

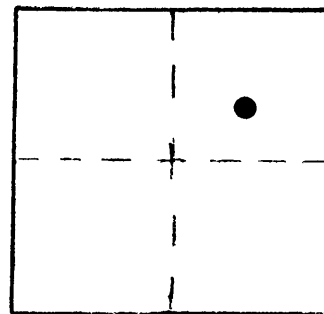

VERTICAL CONTROL NGVD29

Elevation: 492.583 NGS Line # _____ USGS Line # _____ OSHD Line # _____
Precision: 2nd Agency: DCSO Proj. # 2007 Date: 1990

HORIZONTAL CONTROL


South Zone State Plane Coordinates: Y(Northing) _____ X(Easting) _____
Precision: _____ Agency: _____ Proj. # _____ Date: _____
Approximate Geographic Position: Latitude _____ Longitude _____

DESCRIPTION and TO REACH

SKETCH

A DCSO disk stamped "SIVIK 1989" set in an
8 in. dia. by 42 in. long concrete filled
belltile, which is flush with ground.

From the intersection of Colonial Rd.
(Co.Rd.#52) and Laurel Oaks Dr. (Co.Rd.#347)
in T27S,R7W,Sec.13, proceed southerly along
Colonial Rd. 0.1 miles to monument on right.

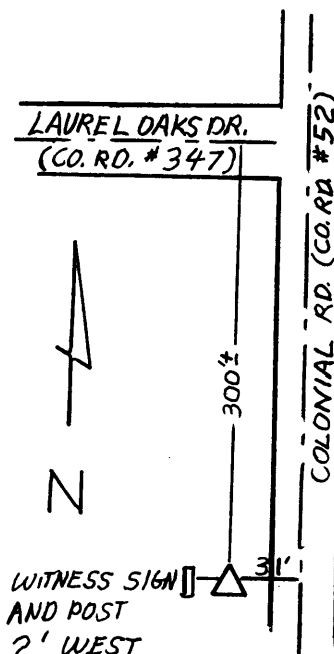

Reference Marks:

Note: For further information, contact the Douglas County Surveyor's Office, Room 205
Douglas County Justice Building, Roseburg, OR 97470. Phone 440-4278. Douglas
County residents outside the Roseburg calling area, dial toll free 1-800-452-0991.