


OFFICE OF THE
DOUGLAS COUNTY SURVEYOR

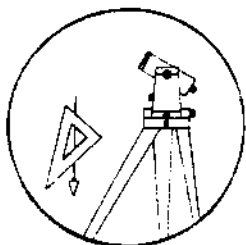

DESIGNATION G-071

VERTICAL CONTROL NGVD29

Elevation: 1,055.692 NGS Line # USGS Line # OSHD Line #

Precision: 2nd Agency: DCSO Proj. # 2007 Date: 1991

HORIZONTAL CONTROL

South Zone O.C.S. 27: Y(Northing) X(Easting)

South Zone O.C.S. 83: Y(Northing) X(Easting)

Precision: Agency: Proj. # Date:


Approx. NAD 83 Geographic Position: Latitude 43°07'09" Longitude 123°07'55"
27

DESCRIPTION and TO REACH

SKETCH

A DCSO disk stamped "GEISE 1991" set in a
8"x40" concrete filled belltile protruding
6" above ground.

From the intersection of North Myrtle Rd.
(Co.Rd.#15) and Slide Creek Rd. (Co.Rd.#149)
in T28S,R4W,Sec.33, proceed northeasterly
along North Myrtle Rd. 3.3 miles to monument
on left.

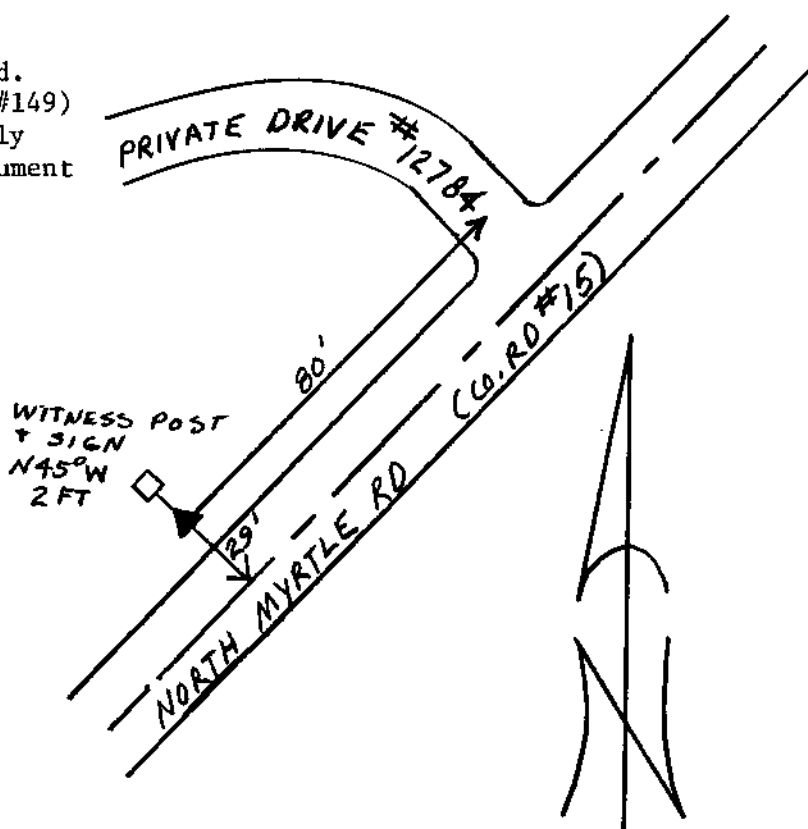

Reference Marks:

Note: For further information, contact the Douglas County Surveyor's Office, Room 205
Douglas County Justice Building, Roseburg, OR 97470. Phone 440-4278. Douglas
County residents outside the Roseburg calling area, dial toll free 1-800-452-0991.