



OFFICE OF THE
DOUGLAS COUNTY SURVEYOR

Station: K 675 T 28 S, R 6 W , Sec 11
Set By (Agency): O.S.H.D.
Date Set: 1978
Recovered By RS, SJF
Date Recovered June 22, 1984
Recovered By _____
Date Recovered _____
Recovered By _____
Date Recovered _____

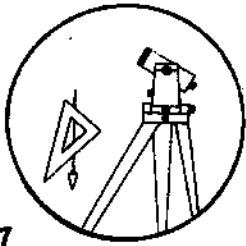

K-017

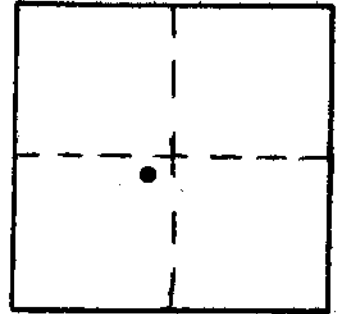

VERTICAL CONTROL NGVD 29

Elevation: 541.16 NGS Line # _____ USGS Line # _____ OSHD Line # 6
Precision: 3rd. Agency: O.S.H.D. Proj. # _____ Date: 1978

HORIZONTAL CONTROL

South Zone State Plane Coordinates: Y(Northing) _____ X(Easting) _____
Precision: _____ Agency: _____ Proj. # _____ Date: _____
Approximate Geographic Position: Latitude _____ Longitude _____


DESCRIPTION and TO REACH

An O.S.H.D. disk stamped "K 675 1978" set flush in concrete sidewalk adjoining a concrete highway railway overcrossing.

TO REACH:

Monument is located in the northeast corner of the State Highway 99 overcrossing of the Southern Pacific Railway tracks in T28S, R6W, Sec. 11.

SKETCH

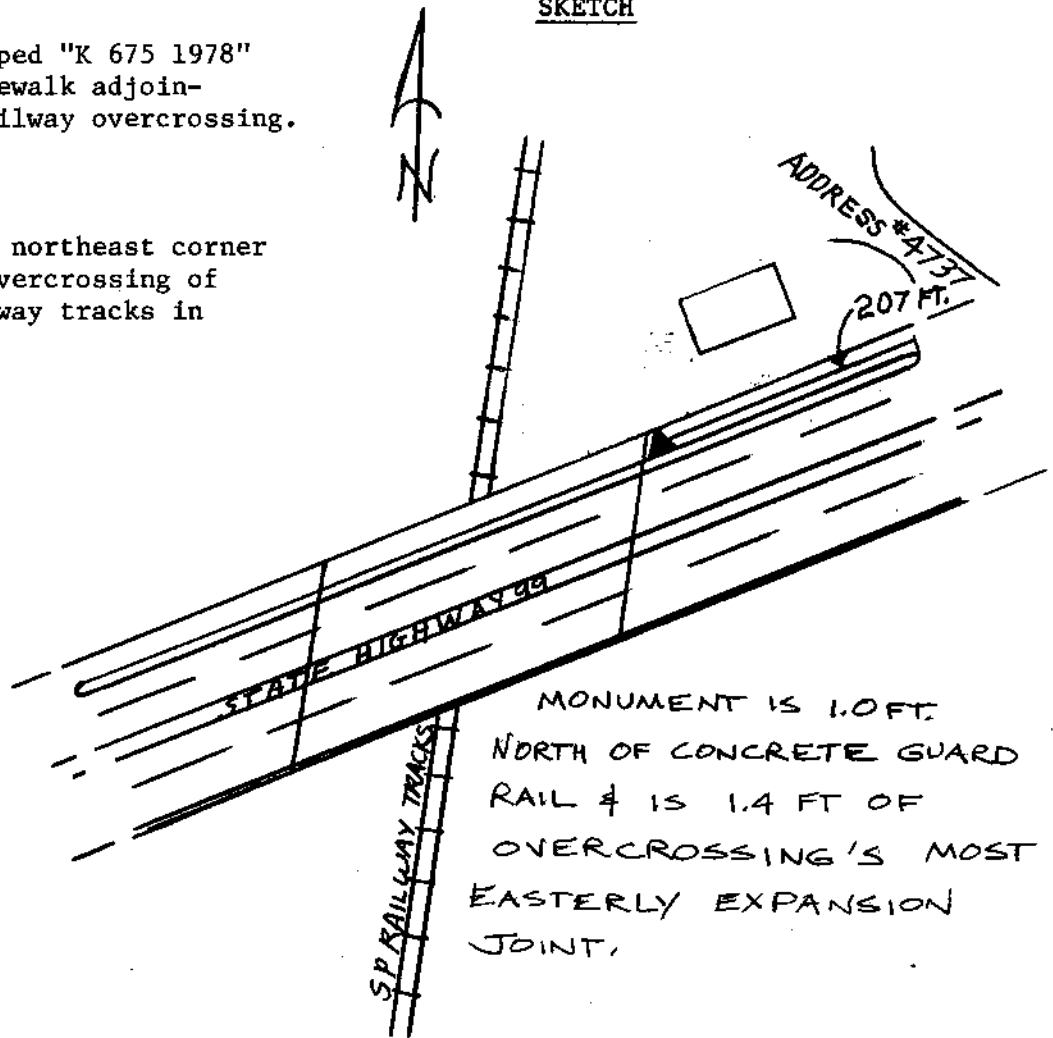

Reference Marks:

Note: For further information, contact the Douglas County Surveyor's Office, Room 205 Douglas County Justice Building, Roseburg, OR 97470. Phone 440-4278. Douglas County residents outside the Roseburg calling area, dial toll free 1-800-452-0991.